


WELLBORE DIAGRAM
 SIMASKO PRODUCTION COMPANY
 STATE-PALACE #1
 NWSE SEC 36 8N 60W
 WELD COUNTY
 05-123-09382

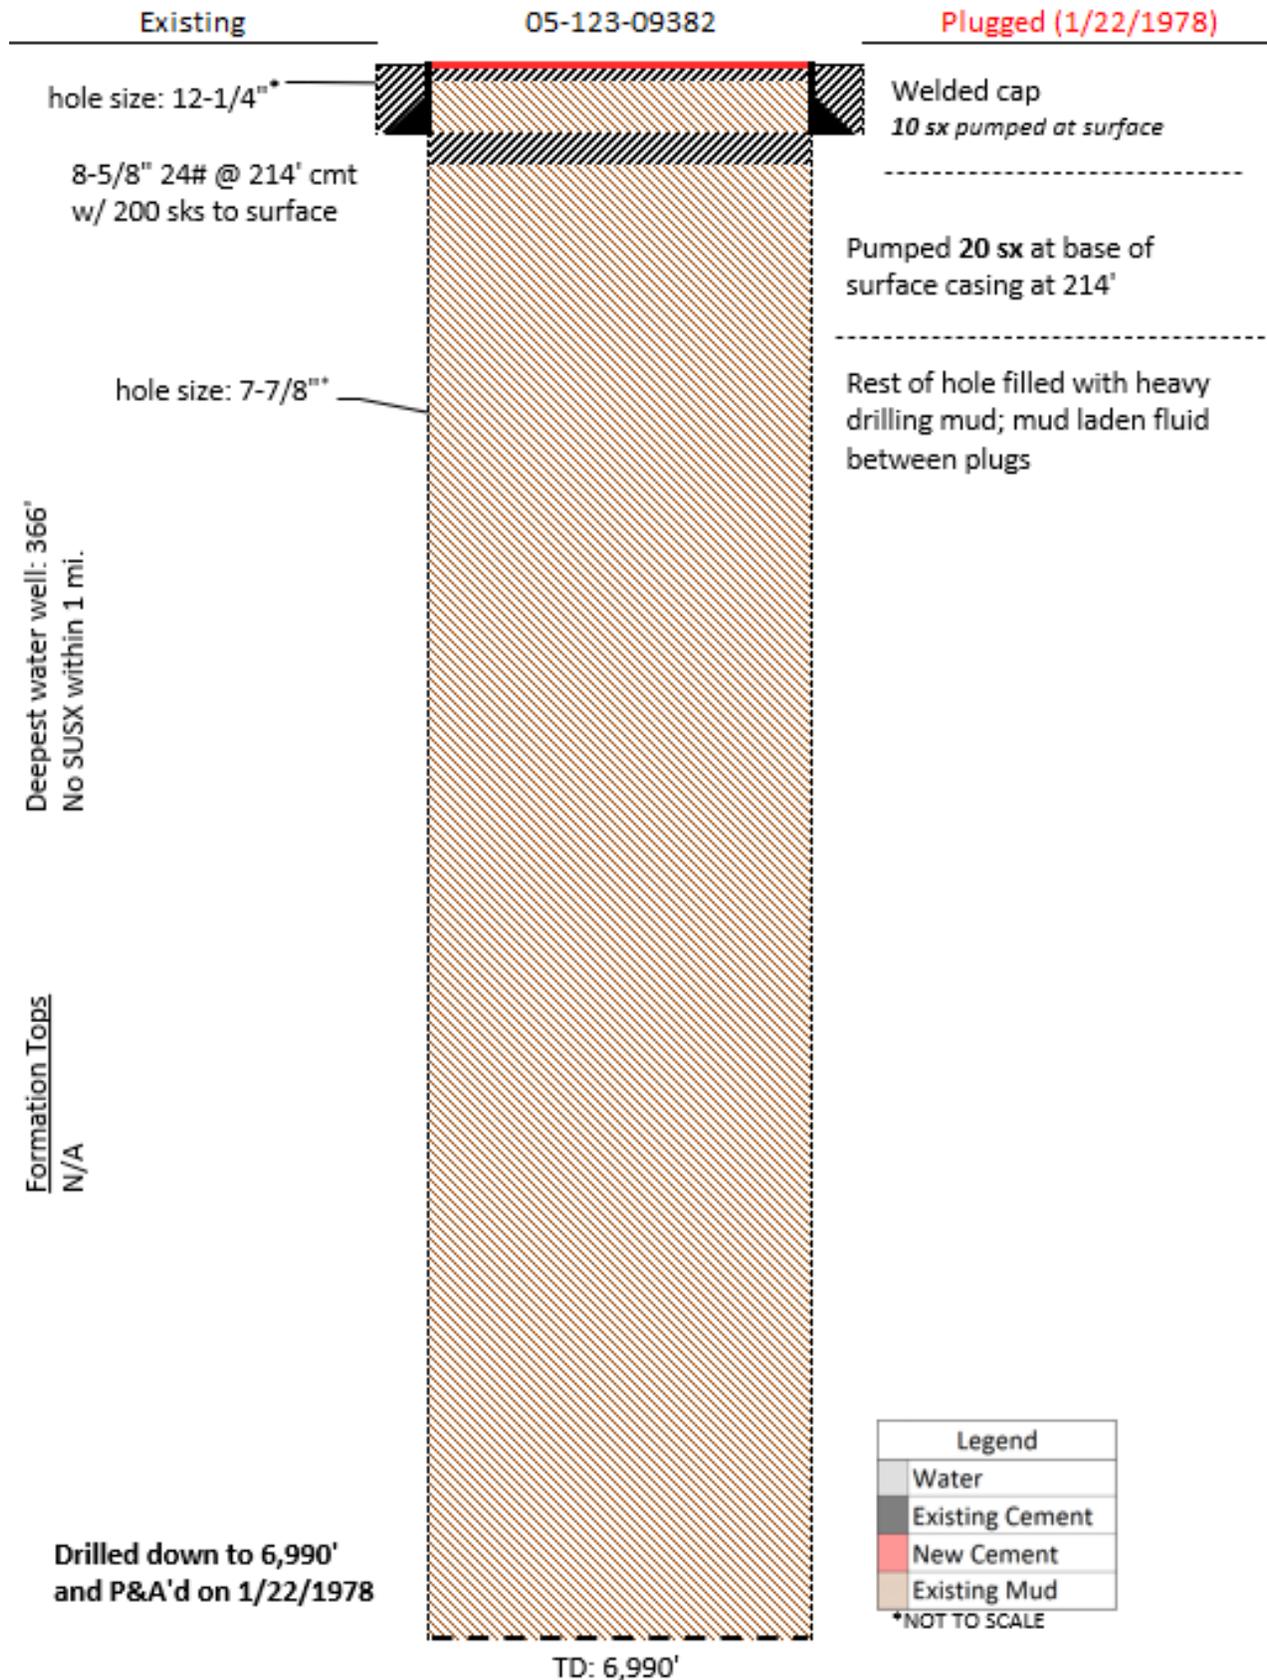

| Legend | |
|--------|-----------------|
| | Water |
| | Existing Cement |
| | New Cement |
| | Existing Mud |

*NOT TO SCALE