




00334210

RECEIVED

MAY 7 1973

GOLD, OIL & GAS CONS. COMM.

R. 60W

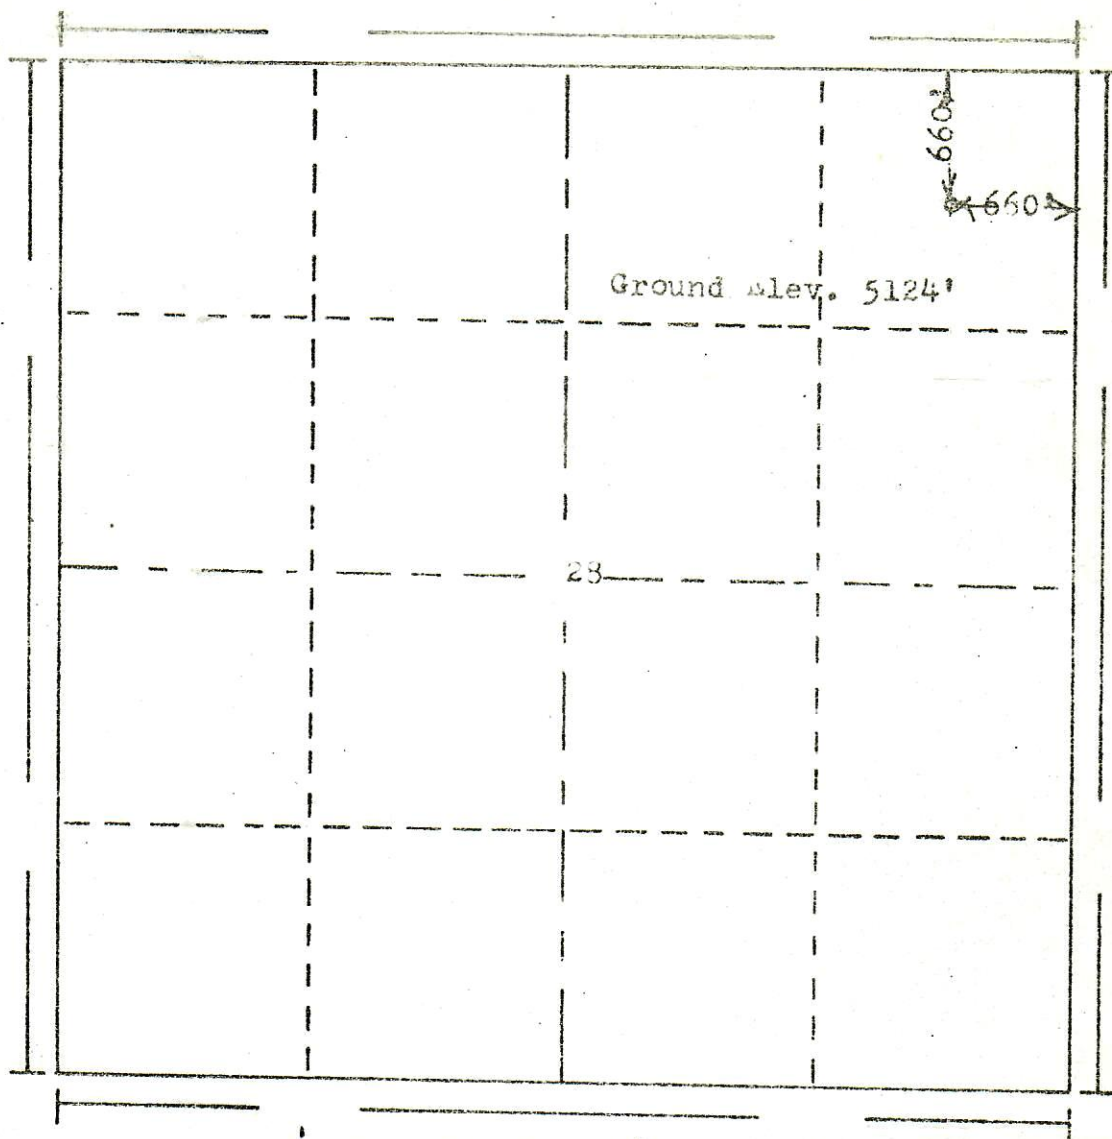

Scale... 1" = 1000'

Powers Elevation Company, Inc. of Denver, Colorado
has in accordance with a request from Mr. Karl
for Edward Mike Davis
determined the location of No. 1-28 slider Industries Inc.
to be CNE NE Section 28 Township 3S
Range 60W of the 6th Principal Meridian
Adams County, Colorado

I hereby certify that this plat is an
accurate representation of a correct
survey showing the location of

Date: 2-23-73

Brian J. Hallaway
Licensed Land Surveyor No. 2853
State of Colorado