P&A Wellbore For State

Well Name: BLEHM N26-17

Land, Original Hole, 8/16/2022 10:21:31 AM

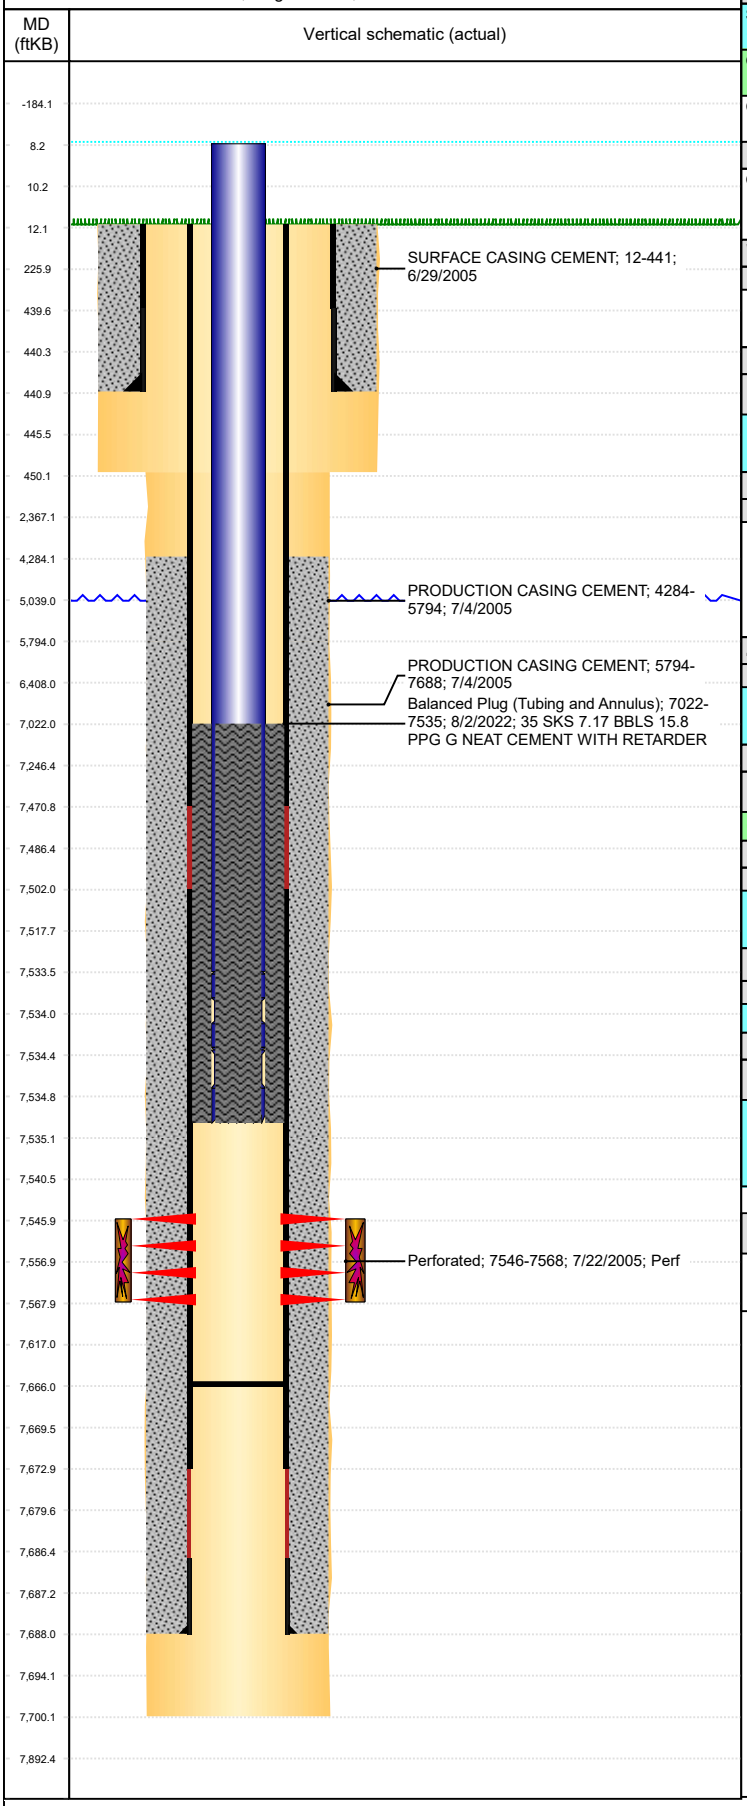

Well Header

Surface UWI	Business Unit	Gov Auth Dist	Prod Tree Loc
0512323036	Rockies		Land

Orig. KB to Gnd (ft)	Original Spud Date	Abandon Date	Well Sub-Status	High…
12.00	6/28/2005		TA	N

Comment

Surface Location (Congressional)

Qtr 3	Qtr 4	Section	Twnshp	Twnsh…	Range	Rng E/…	Latitude (°)	Longitude (°)
NW	NE	26	5	N	67	W	40.374590276	-104.855839988

Wellbore Sections

Section Des	Hole Size (in)	Act Top (ftKB)	Act Btm (ftKB)
SURFACE	12 1/4	12.0	450.0
PRODUCTION	7 7/8	450.0	7,700.0

Casing Strings

Csg Des	Run Date	OD (in)	Wt/Len (lb/ft)	Grade	Top Depth (MD) (ftKB)	Set Depth (MD) (ftKB)
Surface	6/29/2005	8 5/8	24.00	K-55	12	441
Production Casing	7/4/2005	4 1/2	11.60	M-80	12	7688

Cement

Des	Start Date	Top (ftKB)	Btm (ftKB)
SURFACE CASING CEMENT	6/29/2005	12.0	441.0
PRODUCTION CASING CEMENT	7/4/2005	4,284.0	5,794.0
PRODUCTION CASING CEMENT	7/4/2005	5,794.0	7,688.0
Balanced Plug (Tubing and Annulus)	8/2/2022	7,022.0	7,535.0

Zone Statuses

Zone Name	Status Date	Status	Fluid Type	Job	Prod Method
CODELL	1/30/2010	PR			Flowing
CODELL	8/2/2022	Closed		Abandon Well - Temporary, 7/16/2022 08:00	

Perforation Data

Linked Zone	Explosive Type	Entered Shot Total	Top (ftKB)	Btm (ftKB)	Date
CODELL, Original Hole		88	7,546.0	7,568.0	7/22/2005

Stimulation Intervals

Zone	Start Date	Top (ftKB)	Btm (ftKB)
CODELL, Original Hole	7/28/2005	7,546.0	7,568.0
CODELL, Original Hole	9/10/2009	7,546.0	7,568.0

Other In Hole

Run Date	Des	Make	OD (in)	Top (ftKB)	Btm (ftKB)

Logs

Date	Type	Depth Top (MD) (ftKB)	Btm (ftKB)
7/5/2005	COMPENSATED DENSITY	4,400	7,683.0
7/5/2005	INDUCTION	441	7,703.0
7/20/2005	CBL/CCL/GR	4,150	7,655.0

Plug Back Total Depths

Date	Type	Com	PBTD (ftKB)
7/4/2005	GUIDE SHOE		7,673
8/27/2009	FILL		7,666