




00334166

RECEIVED

MAR -2 1970

COLO. OIL & GAS CONS. COMM.

R. 60W

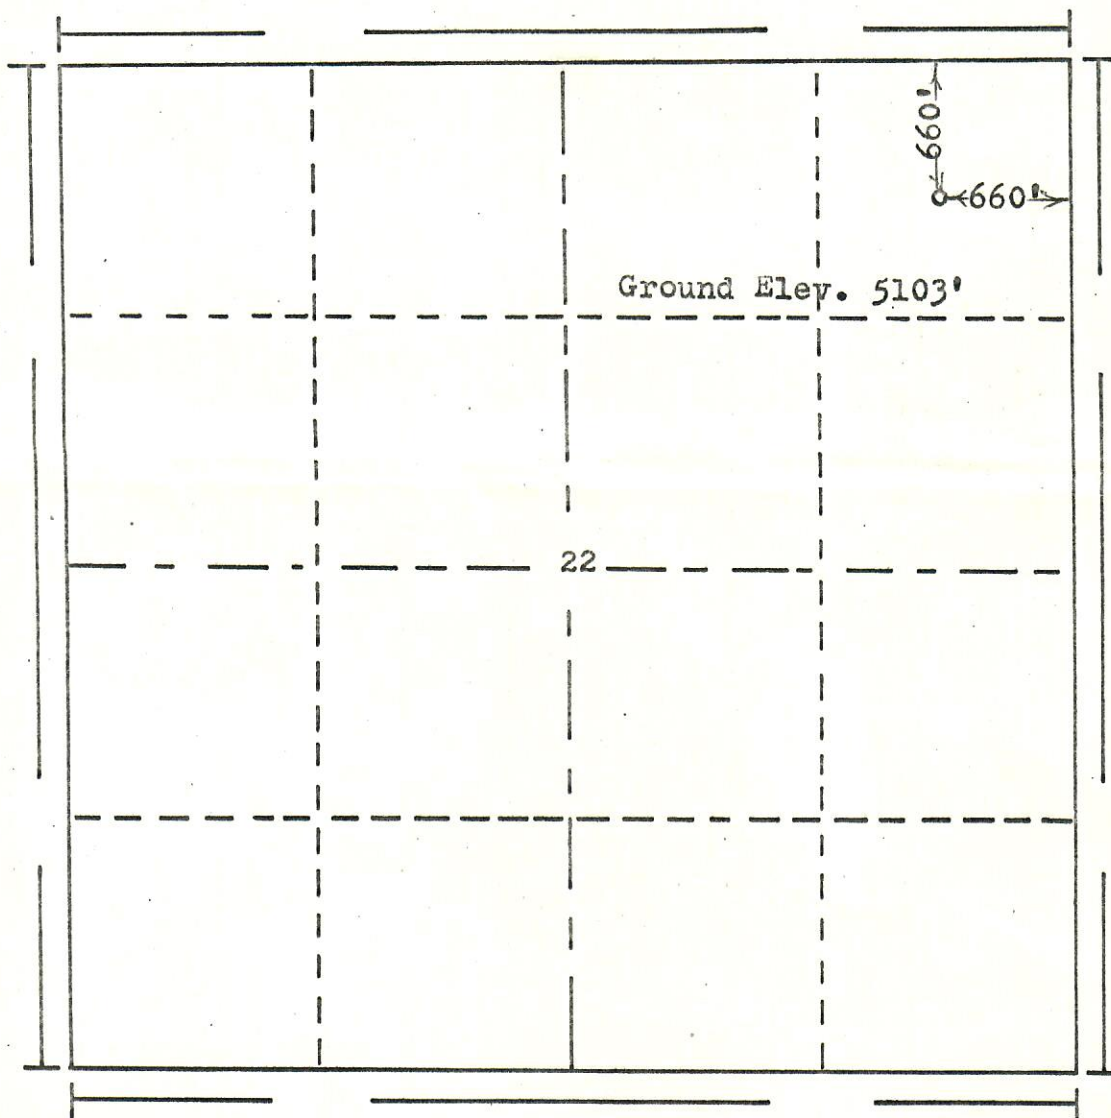

Scale... 1" = 1000'

Powers Elevation Company, Inc. of Denver, Colorado
has in accordance with a request from Mr. Bush
for Tom Vessels

determined the location of No. 1 Kroh
to be CNE NE Section 22 Township 3S
Range 60W of the 6th Principal Meridian
Adams County, Colorado

I hereby certify that this plat is an
accurate representation of a correct
survey showing the location of

Date: 2-2-70

Betty J. Hollman
Licensed Land Surveyor No. 2853
State of Colorado