

OIL AND GAS CONSERVATION COMMISSION  
OF THE STATE OF COLORADORECEIVED  
JAN 19 1959

## NOTICE OF INTENTION TO DRILL

OIL & GAS  
CONSERVATION COMMISSION


## INSTRUCTIONS:

A notice of intention to drill a well shall be filed in duplicate on all Federal and Patented lands, and in triplicate on all State lands. Do not begin operations until approved copy has been received. It is mandatory that the proposed location comply with all rules and regulations of the Commission. Locate well on section grid in proper location, and indicate extent of lease. Unless operations are commenced within 180 days after the date of approval hereof, this approval to drill will become null and void.

J. A. Terteling & Sons, and Brinkerhoff Drilling Company  
Name of Operator Sunshine Mining Company, Jeff Hawks, / Phone No. Acoma 2-0681  
Address 920 Patterson Bldg. City Denver 2 State Colorado

How is liability secured: Well Bond (Attached) ☐; Blanket Bond ☒; Waiver ☐  
(Check one)

Lease Name Mosbarger  
Well No. 2  
Field Name Busy Bee Wildcat ☐  
County Adams

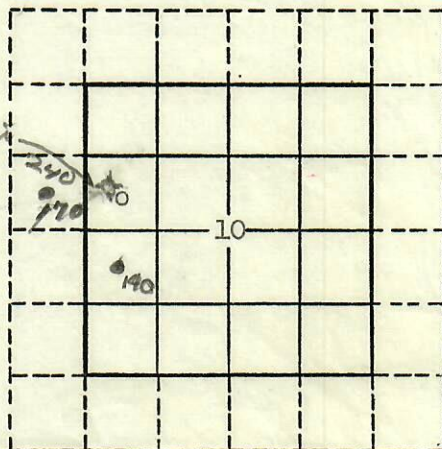

Location SW $\frac{1}{4}$  NW $\frac{1}{4}$  Section 10 Township 3 S Range 60 W Meridian 6th  
(quarter quarter)  
2080 feet from N Section line and 760 feet from W Section Line  
N or S E or W

The well is located on: Patented land ☒ State land ☐ Federal land ☒

The well is located within a spaced area: Yes ☐ No ☒

Distance from proposed location to nearest property or lease line 760 feet.

Distance from proposed location to nearest drilling unit line 760 feet.

Objectives: "D" Sand Formation Depth 6400 Estimate; "J" Sand Formation Depth 6500 Estimate

Proposed length of surface casing 100 feet.

REMARKS:

Area	OK
Spot	Blanket - Sandstone Min.
600 ft.	O/K
1200 ft.	O/K
Wells	
Oil	
Gas	
Status	

I/We hereby swear (or affirm) that the statements herein made are a full and correct report.

APPROVED:

Date JAN 19 1959Company Sunshine Mining Company Date 1/16/59Address 920 Patterson Bldg. Phone No. AC 2-0681By N. L. Ashburn Title Dist. Geologist

Director

Signature