




FORM F-106

001-06629

RECEIVED


JAN 11 1973

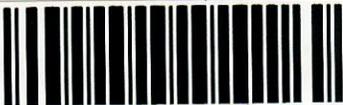

99999999

R. 60W

COLO. Div. of Water Resources

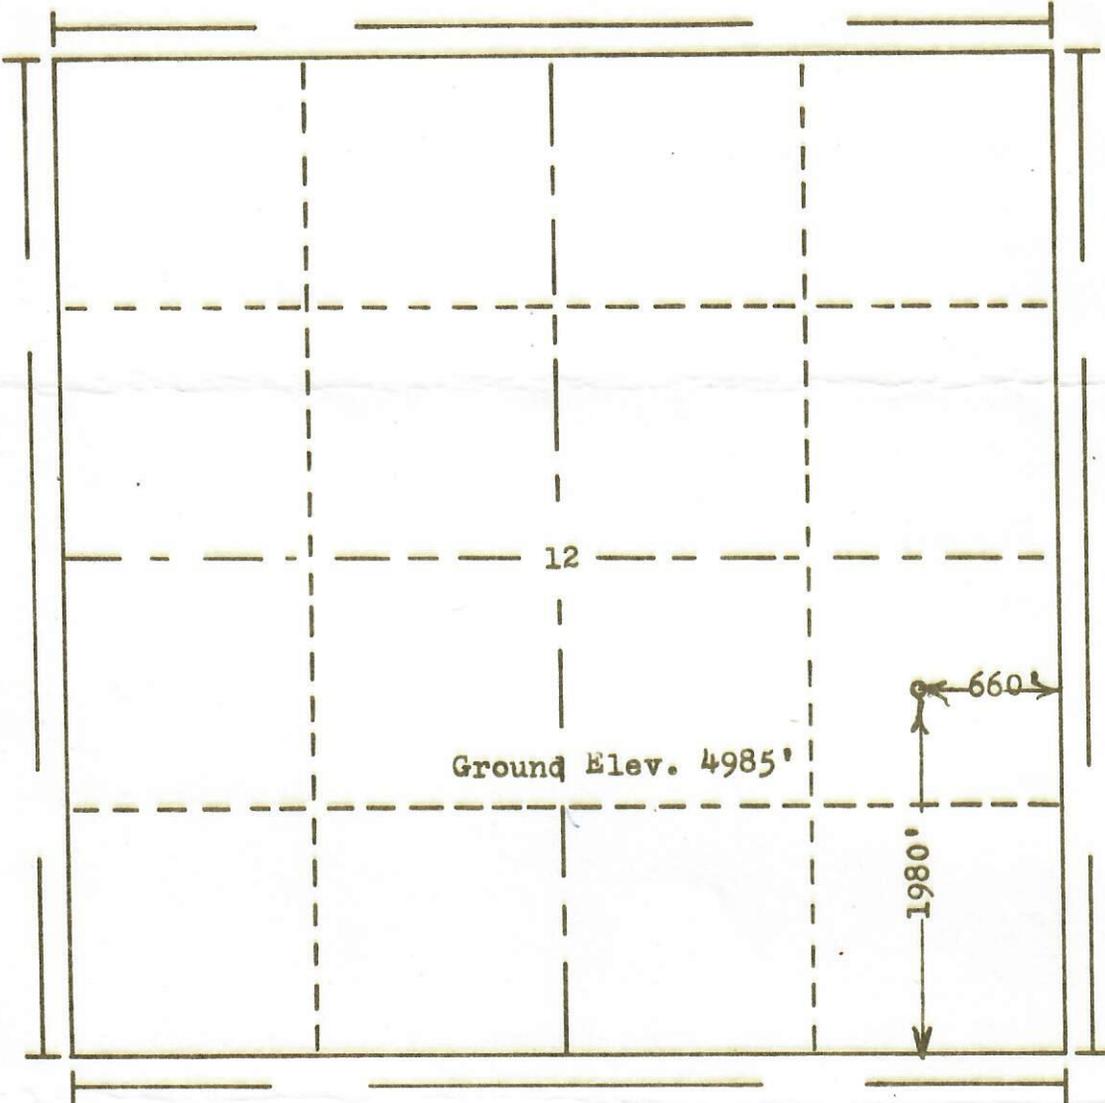

T. 3S

Scale... 1" = 1000'

Powers Elevation Company, Inc. of Denver, Colorado  
 has in accordance with a request from Mr. Zion  
 for Mike Webster & Carl Oil & Gas  
 determined the location of No. ? ?  
 to be CNE SE Section 12 Township 3S  
 Range 60W of the 6th Principal Meridian  
Adams County, Colorado

I hereby certify that this plat is an  
 accurate representation of a correct  
 survey showing the location of

13-7

Date: 1-3-73

*B. J. Hollaway*



00326455

Licensed Land Surveyor No. 2853  
 State of Colorado