




RECEIVED

JUL 28 1971

COLO. OIL & GAS CONS. COMM.

R. 60W

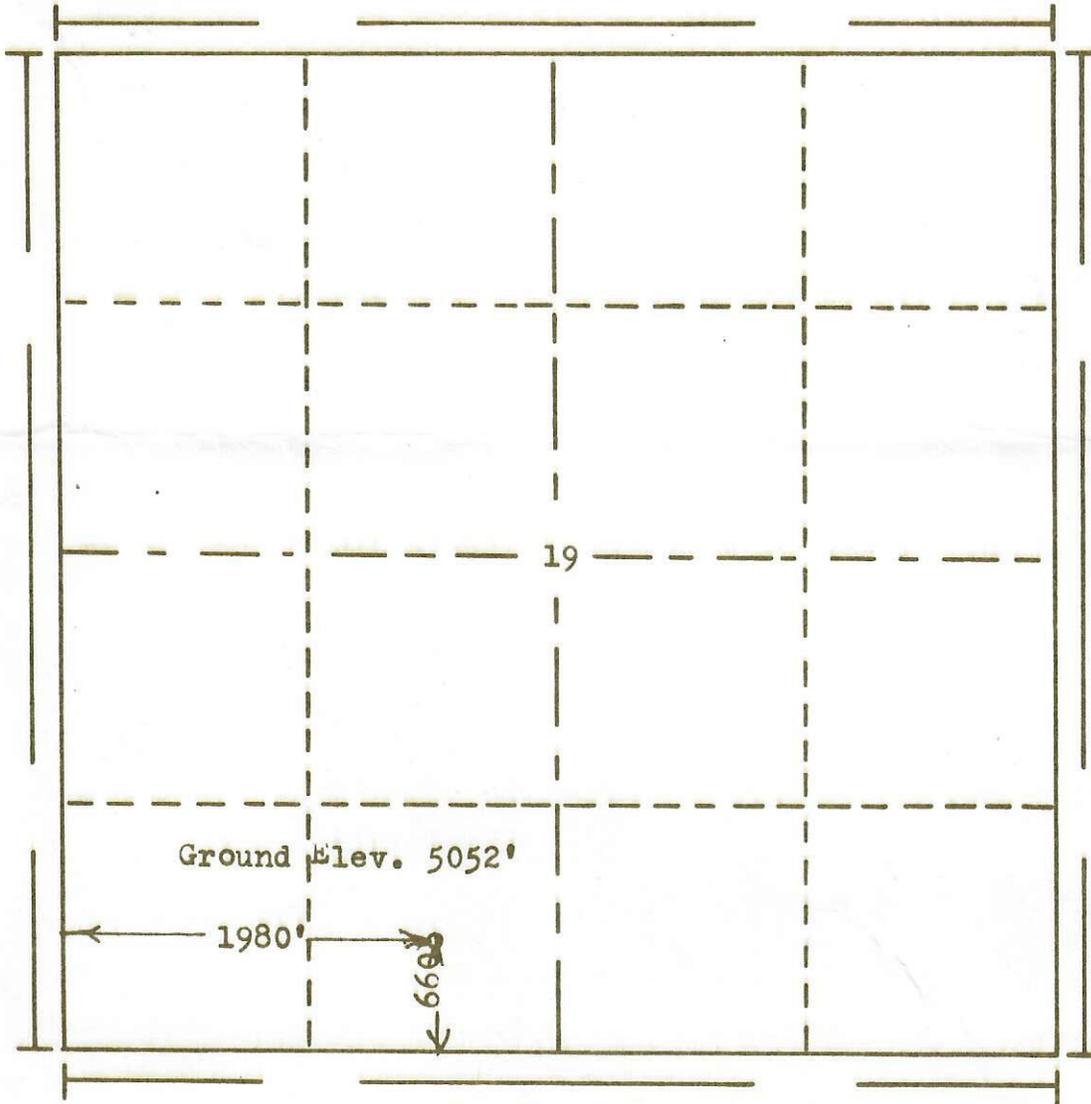

T.
3
S

Scale... 1" = 1000'

Powers Elevation Company, Inc. of Denver, Colorado
 has in accordance with a request from Mr. Zion
 for U.S. Gold
 determined the location of No. ? ?
 to be CSE SW Section 19 Township 3S
 Range 60W of the 6th principal Meridian
Adams County, Colorado

I hereby certify that this plat is an
 accurate representation of a correct
 survey showing the location of

Date: 7-23-71

David J. Hoover
 Licensed Land Surveyor No. 2853
 State of Colorado