



FORM F-106



00334128

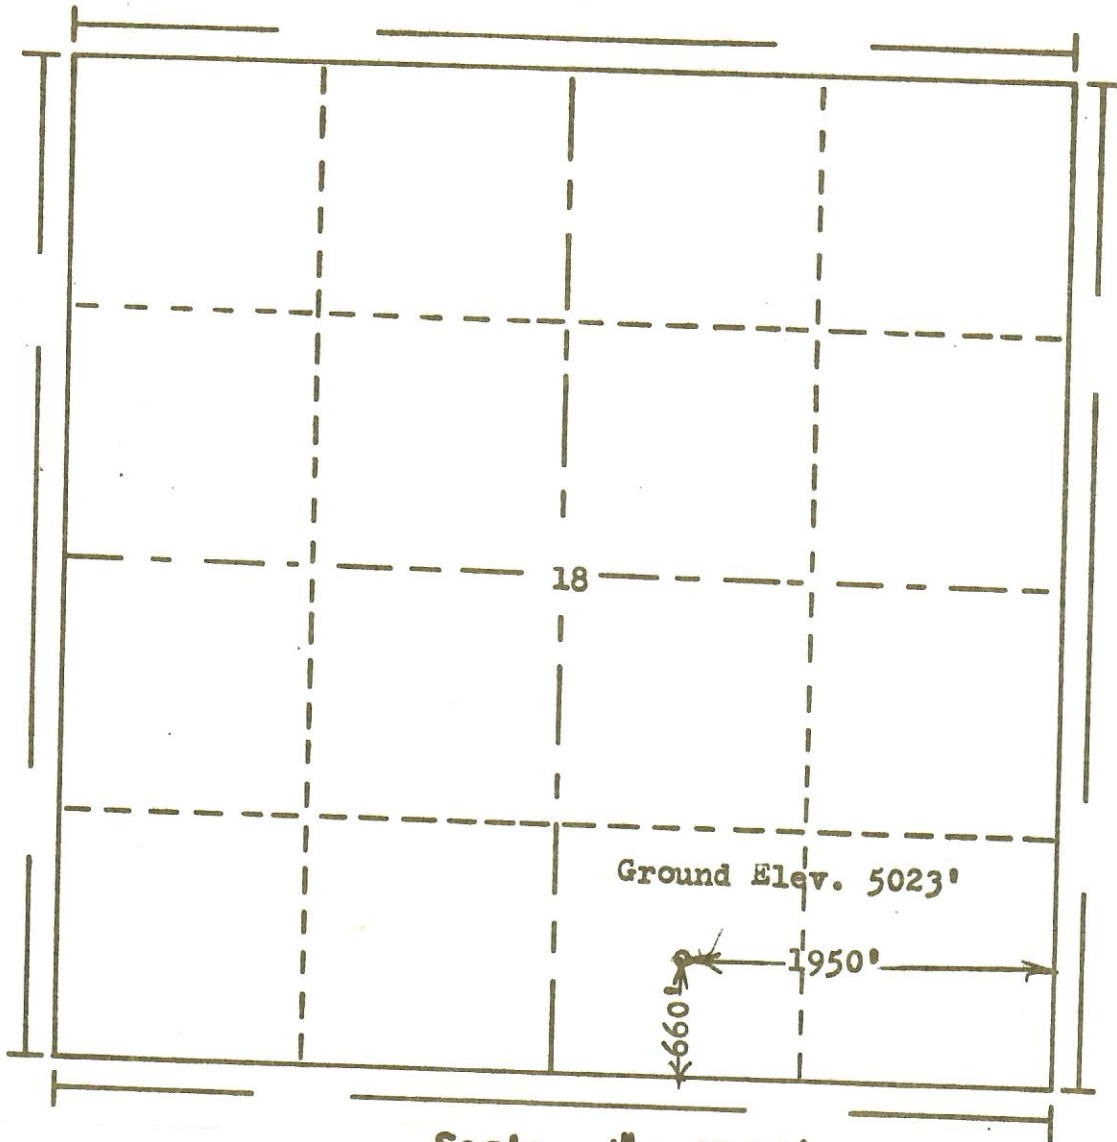
JUN 13 1972

RECEIVED

JUN 14 1972

COLD. CH. & PDS. COMM.

R. 60W

T.
3
S

Scale... 1" = 1000'

Powers Elevation Company, Inc. of Denver, Colorado
has in accordance with a request from Mr. Johnson
for ~~Norix Flader~~ Allison Drlg. Co.
determined the location of ~~CSW SE~~ No. 1 Flader "A"
to be CSW SE Section 18 Township 3S
Range 60W of the 6th Principal Meridian
Adams County, Colorado

I hereby certify that this plat is an
accurate representation of a correct
survey showing the location of

Date: 6-8-72

B. H. Hall
Licensed Land Surveyor No. 2853
State of Colorado

72-435