

RECEIVED
JUL 22 1960
OIL & GAS
CONSERVATION COMMISSION

RECEIVED
JUL 15 1960
OIL & GAS
CONSERVATION COMMISSION

OIL AND GAS CONSERVATION COMMISSION
OF THE STATE OF COLORADO

NOTICE OF INTENTION TO DRILL



INSTRUCTIONS:

A notice of intention to drill a well shall be filed in duplicate on all Federal and Patented lands, and in triplicate on all State lands. Do not begin operations until approved copy has been received. It is mandatory that the proposed location comply with all rules and regulations of the Commission. Locate well on section grid in proper location, and indicate extent of lease. Unless operations are commenced within 180 days after the date of approval hereof, this approval to drill will become null and void.


Name of Operator DeVaughn Oil & Gas Co. Phone No. UN7-6398
Address P O Box 211 City Ft. Morgan State Colorado

How is liability secured: Well Bond (Attached) ; Blanket Bond ; Waiver
(Check one)

Well Bond #880843

SEE ATTACHED
FOR WAIVER FROM
JEFF HAWKS

Lease Name Flader
Well No. 1
Field Name Flint Wildcat
County Adams

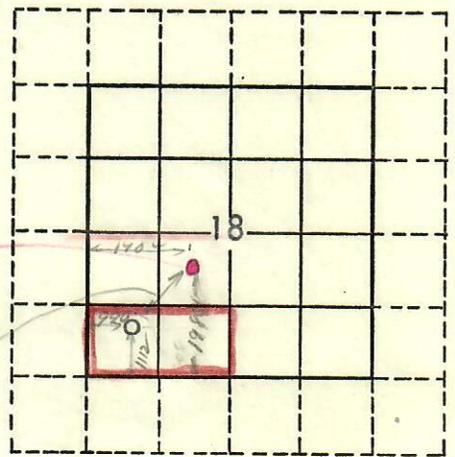

Extent of DEVAUGHN
LEASE - 1/2 SW/4 - SEC 18

Location SW SW (quarter quarter) Section 18 Township 3S Range 60W Meridian 6th PM
1112 feet from S Section line and 940 feet from W Section Line
N or S E or W

The well is located on: Patented land State land Federal land

The well is located within a spaced area: Yes No

Distance from proposed location to nearest property or lease line 1112 feet.
Distance from proposed location to nearest drilling unit line 380 feet.

Objectives: "D" Sand Depth 6495; "J" Sand Depth 6550
Formation Estimate Formation Estimate

Proposed length of surface casing 120 feet.

REMARKS:

Agent	<u>6P Attached</u>
Bond	
Spot	
600 ft.	<u>W</u>
1200 ft.	
Wells	
Oil	
Gas	
Status	

I/We hereby swear (or affirm) that the statements herein made are a full and correct report.

APPROVED:

Date July 22, 1960
[Signature]
Director

Company Decker Drilling, Inc Date July 14, 1960
Address 210 Johnson Bldg. Phone No. MA3-5750
By Decker N. Squires Title President
Signature

(R)