




00789809

R. 55 W.

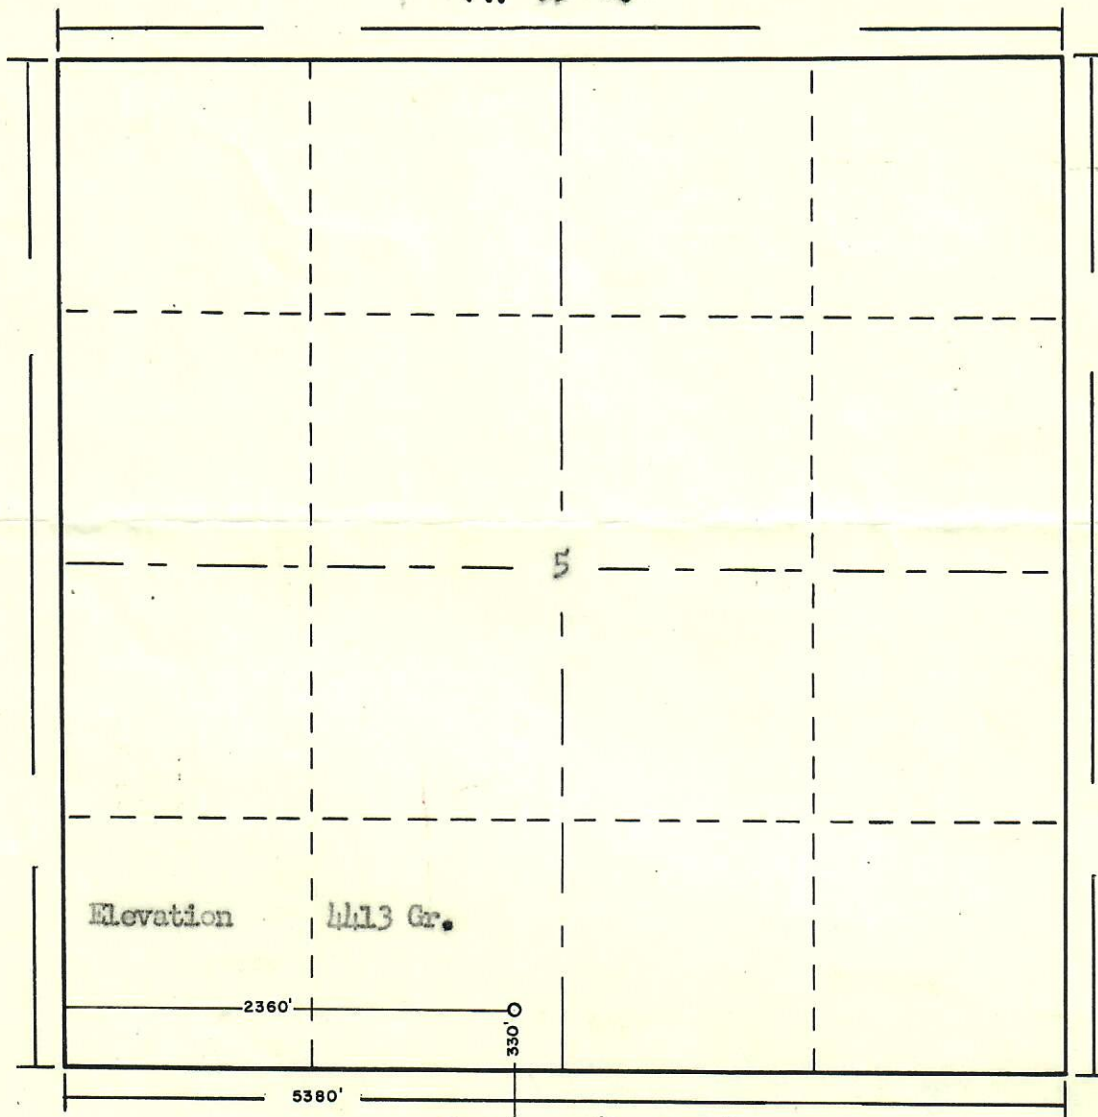

Scale ... 1" = 1000'

Powers Elevation Company of Casper, Wyoming
 has in accordance with a request from Mr. Charley Chittum
 for Charley Chittum determined the

Location of #1 Well

to be SE SE SW

Range 55 West

Logan

Section 5 Township 9 North


6th Principal

Meridian

County,

Colorado

The above Plat shows the location of the well site
 in said section.

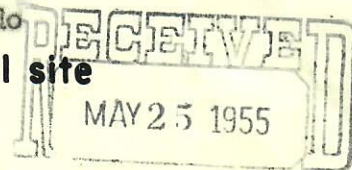

Powers Elevation Company

by: *Burr Lebert*

Date: 5-20-55

Registered Land Surveyor

