




00241517

RECEIVED

JUL 29 1970

COLO. OIL &amp; GAS CONS. COMM.

R. 55W

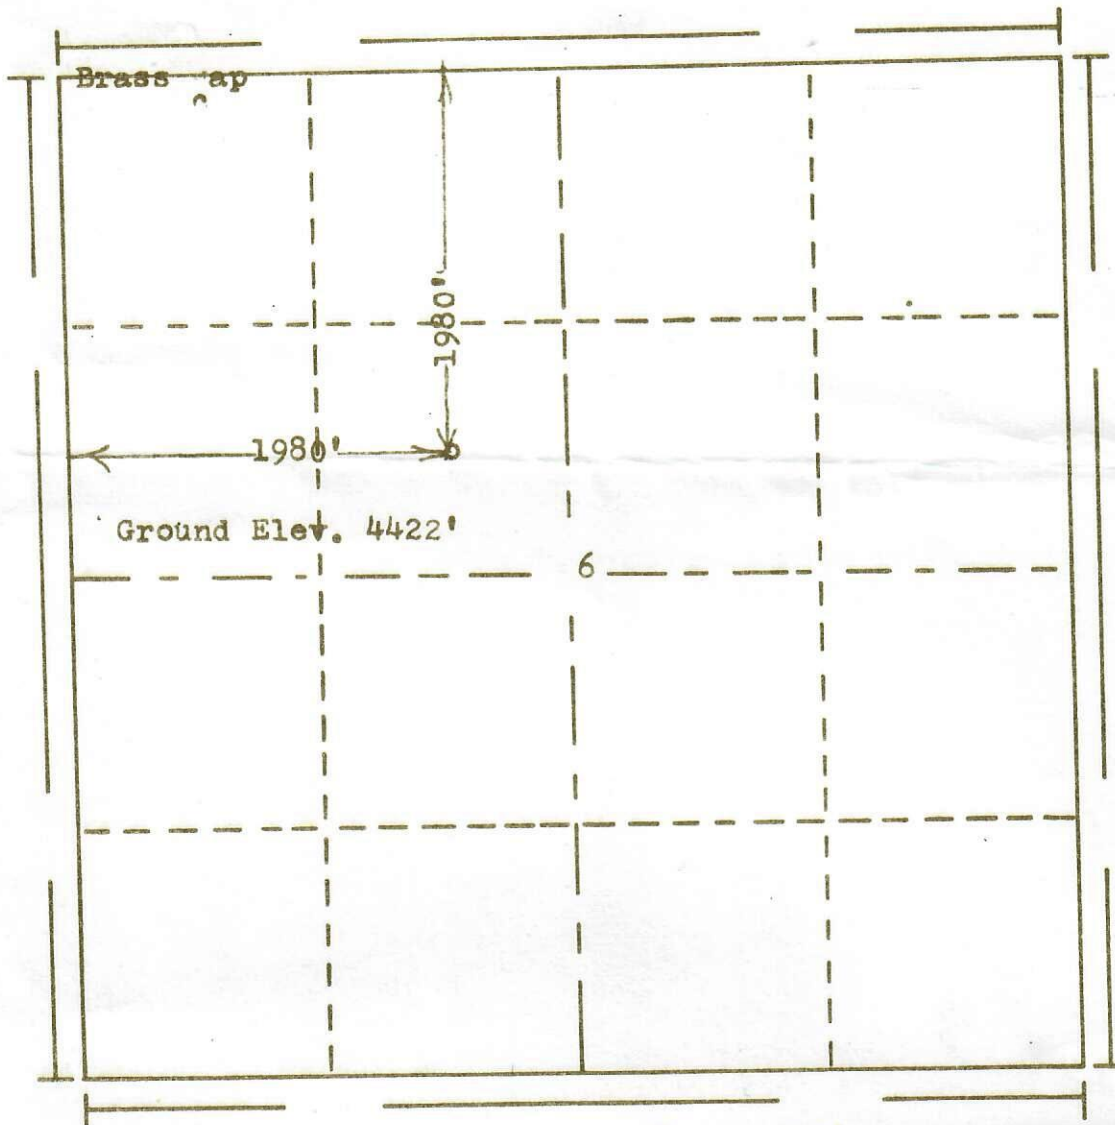

T. 9N

Scale... 1" = 1000'

Powers Elevation Company, Inc. of Denver, Colorado  
has in accordance with a request from Mr. Brown  
for Plains Exploration Co.  
determined the location of No. 1 Cervi  
to be CSE NW Section 6 Township 9N  
Range 55W of the 6th Principal Meridian  
Logan County, Colorado

I hereby certify that this plat is an  
accurate representation of a correct  
survey showing the location of

Date: 7-25-70

Beverly J. Holman  
Licensed Land Surveyor No. 2853  
State of Colorado

70-333