



**Legend**

- Underground Flowline Location  
(Collected via Trimble GPS)
- Excavation Extent  
(Collected via Trimble GPS)
- + Soil Boring Location  
(Collected via Trimble GPS)

**Notes**

All locations are approximate unless otherwise noted.

GPS – Global Positioning System

0 ft.                      20 ft.                      40 ft.

Image Source: Google Earth; June 2021  
Projection: WGS 84 UTM Zone 13 North

DATE: August 12, 2022

---

DESIGNED BY: C. Hamlin

---

DRAWN BY: E. Wozniak

**Tasman, Inc.**  
6855 W. 119<sup>th</sup> Ave.  
Broomfield, CO 80020

**PDC Energy, Inc. – DJ Basin**  
**Former Witwer 34,44-6D Tank Battery**  
NESE Section 6, Township 5 North, Range 64 West  
Weld County, Colorado

SOIL BORING  
LOCATION MAP

FIGURE  
1



**Legend**

-  Underground Flowline Location  
(Collected via Trimble GPS)
-  Excavation Extent  
(Collected via Trimble GPS)
-  Soil Boring Location  
(Collected via Trimble GPS)

**Notes**

All locations are approximate unless otherwise noted.

GPS – Global Positioning System

0 ft.                      10 ft.                      20 ft.

Image Source: Google Earth; June 2021  
Projection: WGS 84 UTM Zone 13 North



DATE:	August 12, 2022
DESIGNED BY:	C. Hamlin
DRAWN BY:	E. Wozniak



**Tasman, Inc.**  
6855 W. 119<sup>th</sup> Ave.  
Broomfield, CO 80020

**PDC Energy, Inc. – DJ Basin**  
**Former Witwer 44-6D Wellhead**  
NESE Section 6, Township 5 North, Range 64 West  
Weld County, Colorado

SOIL BORING  
LOCATION MAP

FIGURE  
2



**Legend**

-  Excavation Extent  
(Collected via Trimble GPS)
-  Proposed Soil Boring Location

**Notes**

All locations are approximate unless otherwise noted.

GPS – Global Positioning System

0 ft.                      10 ft.                      20 ft.

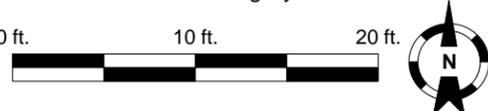


Image Source: Google Earth; July 2019  
Projection: WGS 84 UTM Zone 13 North

DATE: August 15, 2022

DESIGNED BY: C. Hamlin

DRAWN BY: K. Shepherd



**TASMAN** Tasman, Inc.  
6855 W. 119<sup>th</sup> Ave.  
Broomfield, CO 80020

**PDC Energy, Inc. – DJ Basin**  
**Former Witwer 34,44-6D Production Facility**  
NESE Section 6, Township 5 North, Range 64 West  
Weld County, Colorado

**PROPOSED SOIL BORING  
LOCATION MAP  
(TANK BATTERY)**

**FIGURE  
3**