


Well/Facility: Little Beaver Unit #51 Well Status: P&A  
 Operator: Magpie Operating Inc Formation: J Sand  
 Lease/Op Agmt: \_\_\_\_\_ Prod Interval: \_\_\_\_\_  
 Field: Little Beaver API #: 05-121-06195  
 County: Washington GR/KB: 4646' KB  
 State: CO TD: 5,252'  
 Spud: 10/6/1953 PBTD: 5,216'  
 Comp. Date: 10/13/1953 WI: \_\_\_\_\_  
 1st Prod: 10/20/1953 NRI: \_\_\_\_\_  
 Xmas tree: \_\_\_\_\_  
 Surface Loc: 2310 FNL 1650 FWL  
 Sec-Twn-Rge: SENW 5 2S56W  
 Comments: FINAL ABANDONMENT DIAGRAM  
 \_\_\_\_\_  
 \_\_\_\_\_  
 \_\_\_\_\_

Date Drawn: Apr-2-2018

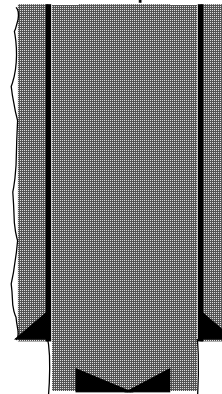

Cut off and Weld on Cap 4' below surface.

Hole Size  
12-1/4"

Surface Csg @ 99'  
10-3/4"  
Cement to surface 55 sx

Circulate 70 sx from 140' to 0'

Casing cut below 140'  
Exact amt of casing  
pulled is unknown

Hole Size 7-7/8"

2 sx of cement  
CIBP @ 4,860

Perfs - D Sand  
5194' - 5202'

Prod Csg @ 5,216'  
5-1/2"  
150 sx cement

Gologic Markers	
MD	
4,825	Carlile
4,907	Greenhorn
5,220	D Sand
5,302	J Sand