


Hold Int. w/ this plot if it comes in 10/26/60

N

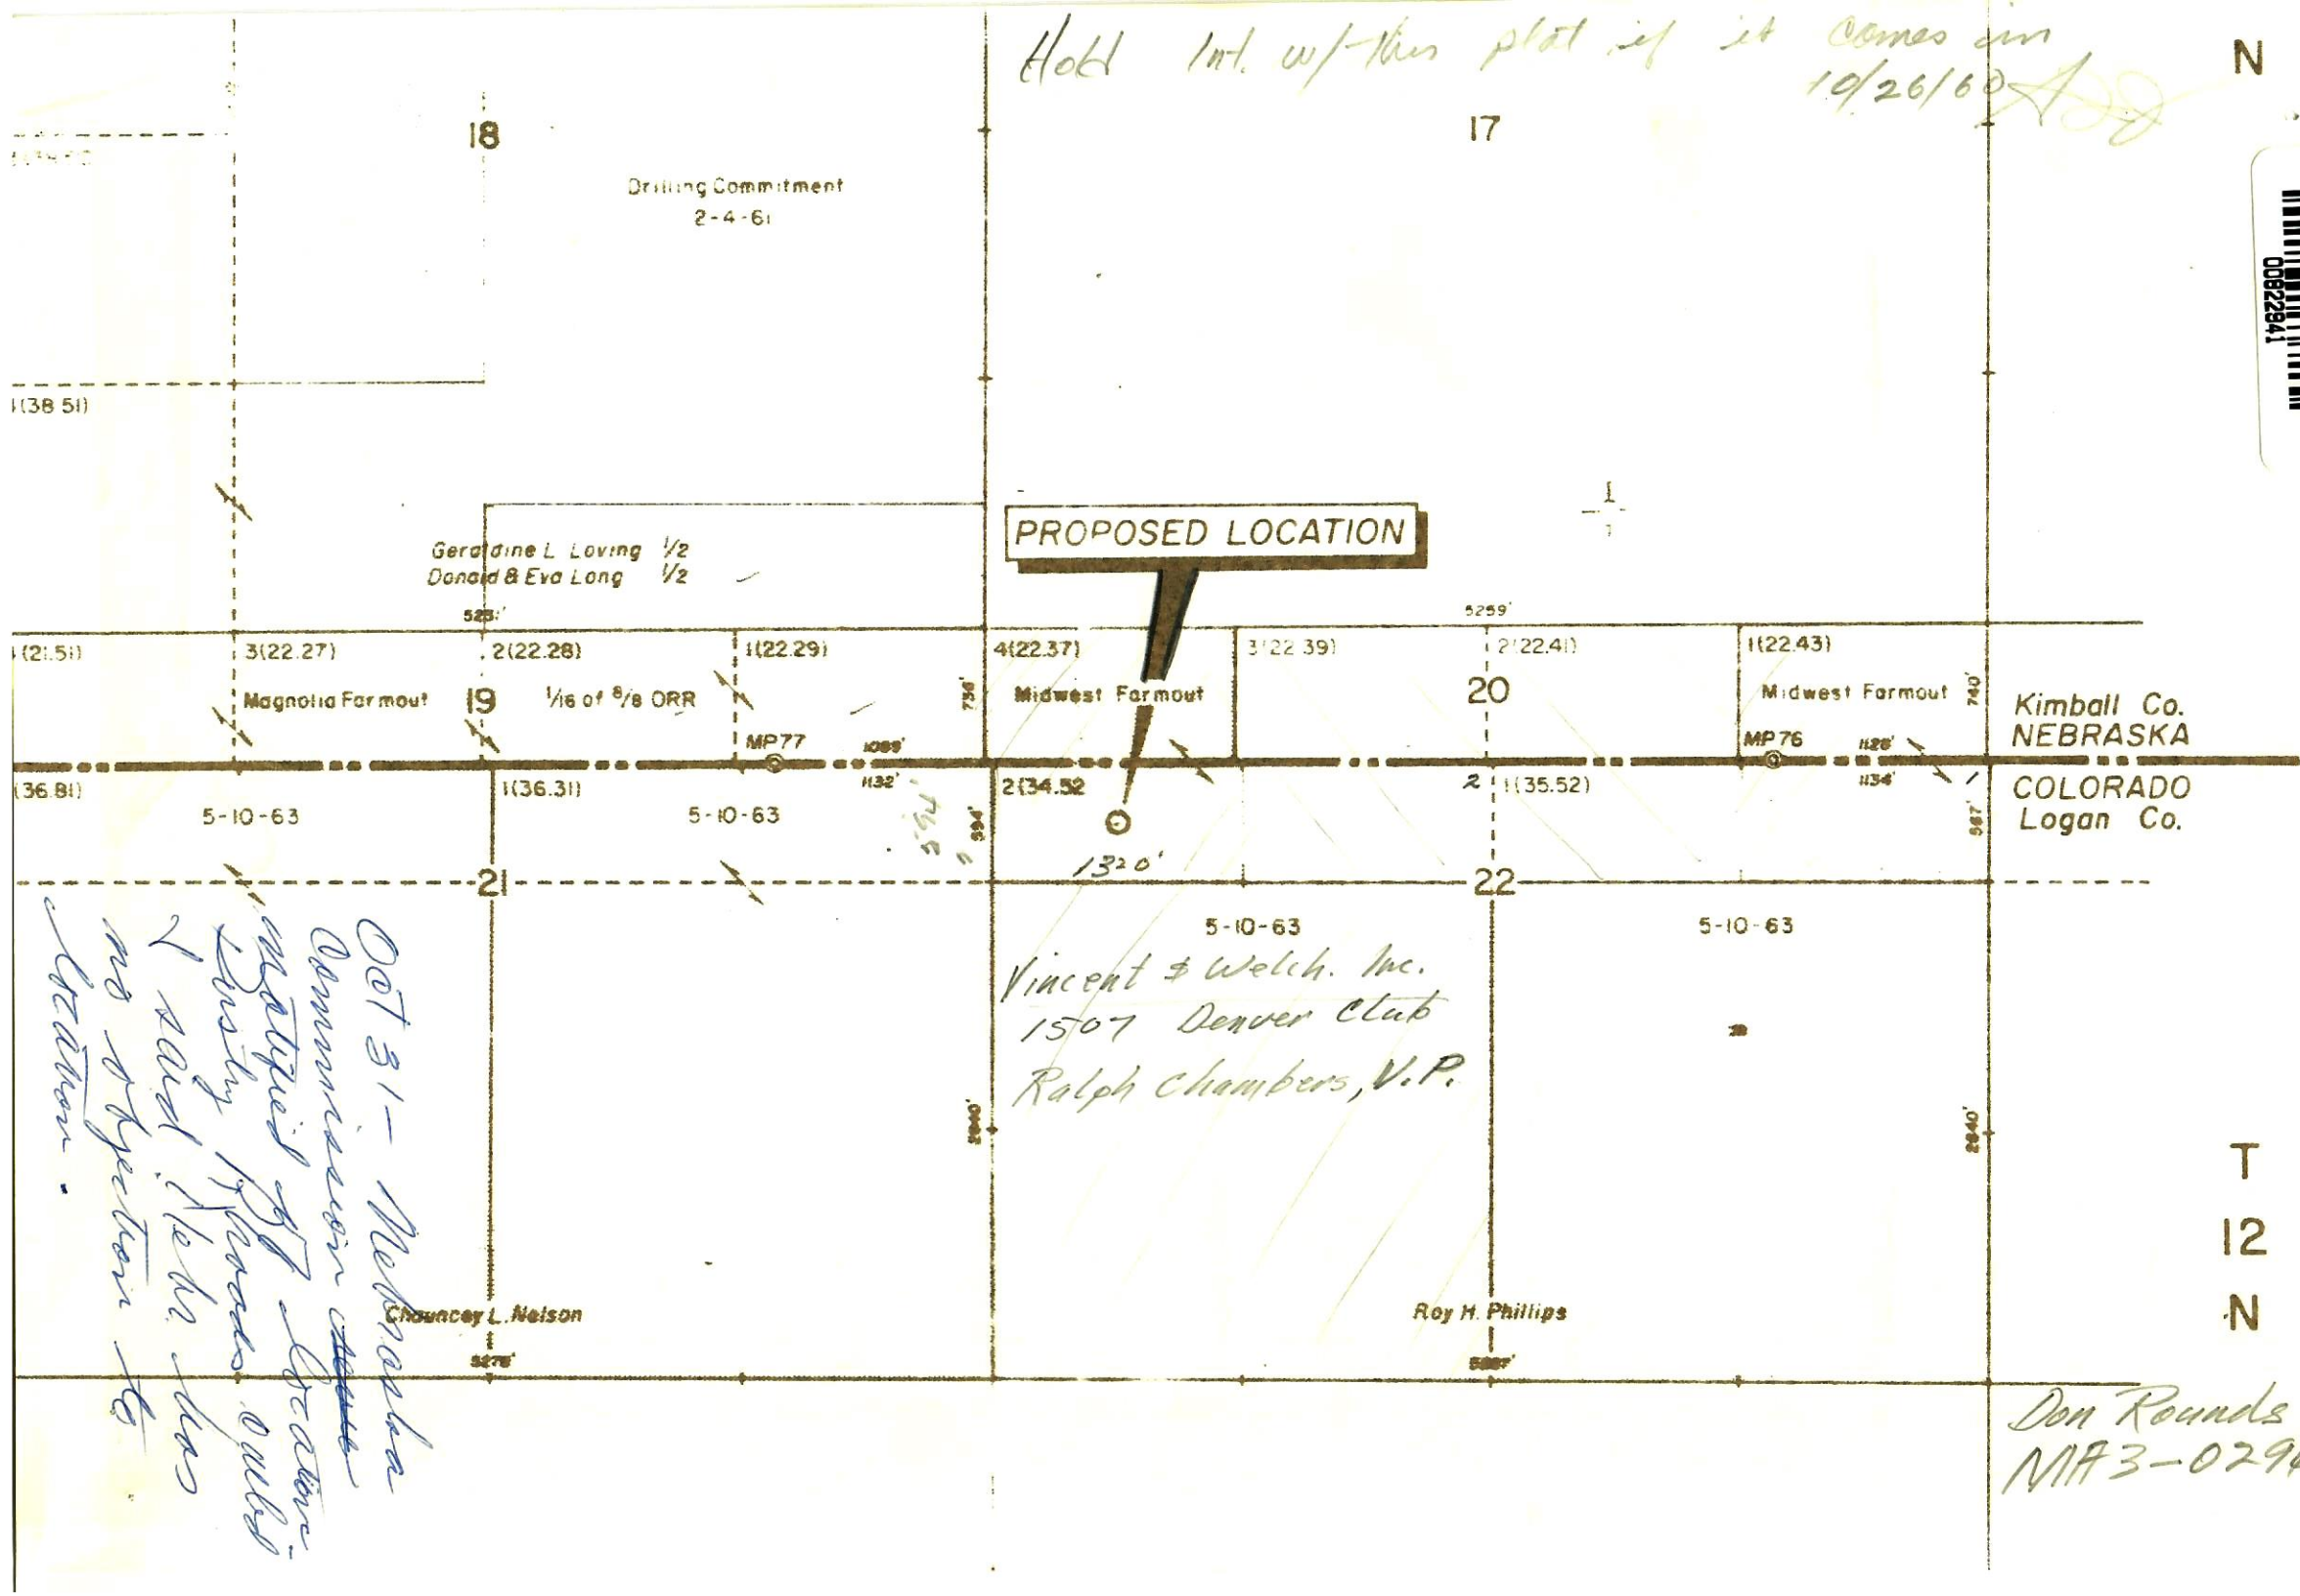

PROPOSED LOCATION

Geraldine L. Loving 1/2  
Donald & Eva Long 1/2

Magnolia Farmout

Midwest Farmout

Midwest Farmout

Kimball Co.  
NEBRASKA

COLORADO  
Logan Co.

5-10-63  
Vincent & Welch, Inc.  
1507 Denver Club  
Ralph Chambers, V.P.

Chauncey L. Nelson

Roy H. Phillips

T  
12  
N

Don Rounds  
MA3-0296

Oct 31 - Nebraska  
Commissioner ~~State~~  
location.