

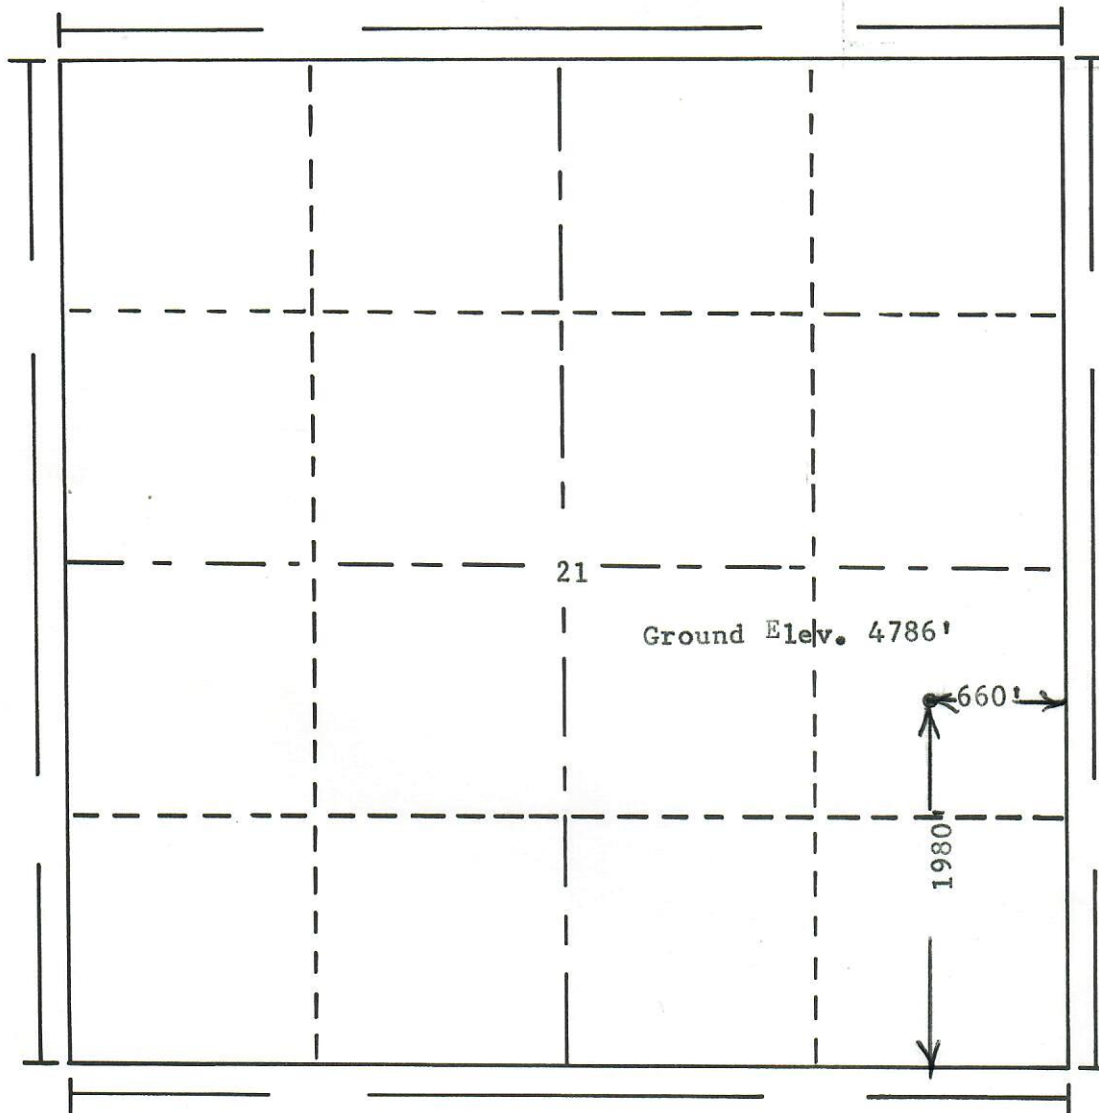


RECEIVED

JUL - 3 1973

COLO. OIL &amp; GAS COM. COMM.

R. 55W

T.  
12  
N

Scale... 1" = 1000'

Powers Elevation Company, Inc. of Denver, Colorado  
has in accordance with a request from Michelle  
for Summit Oil Co. & Exeter Drilg. & Exploration Co.  
determined the location of No. A-1 Nelson  
to be CNE SE Section 21 Township 12N  
Range 55W of the 6th Principal Meridian  
Logan County, Colorado



00290837

I hereby certify that this plat is an  
accurate representation of a correct  
survey showing the location of

Date: 6-11-73

Billy R. Holloway  
Licensed Land Surveyor No. 2853  
State of Colorado