


CERTIFICATE OF SURVEY
for
Delfern Oil Co.



99999999

T12N R55N 6PM.

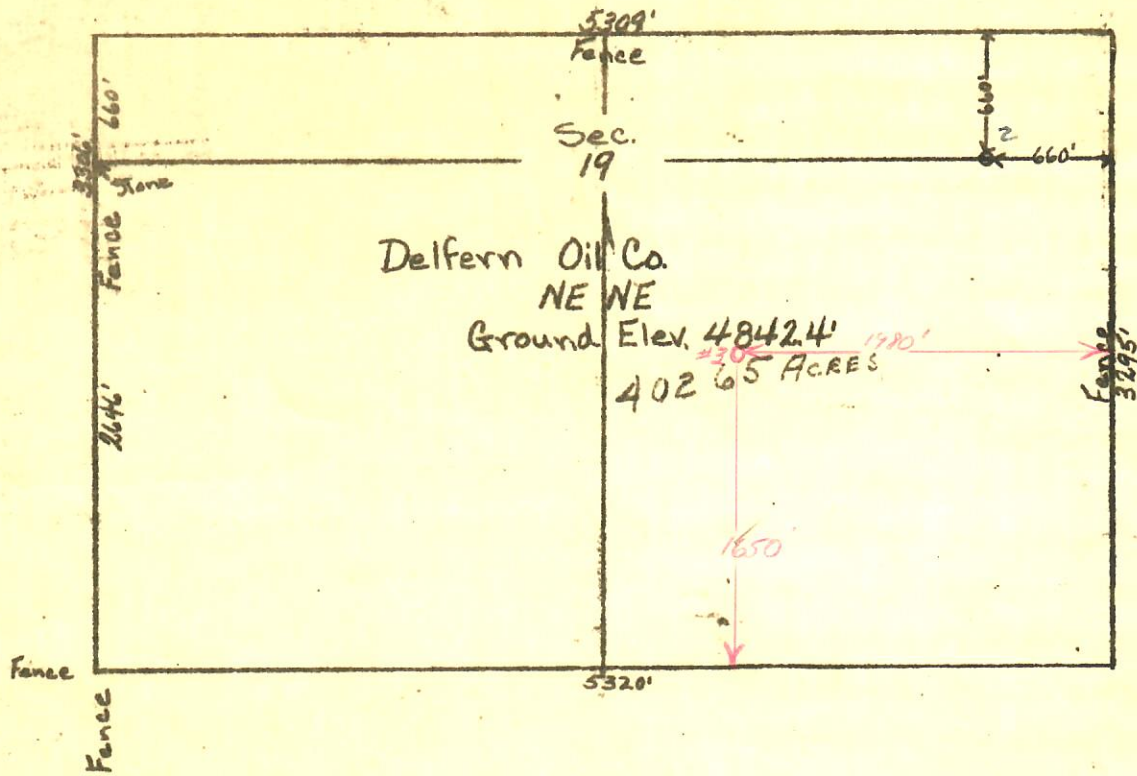


Scale 1" = 1000'

I hereby certify that the above plat is an accurate representation of a correct survey showing the location of Delfern Oil Co.- Oilwell located in the NE 1/4 Sec. 19 T12N R55W 6 PM. The elevation of the ground at the stake is 4842.4 feet above sea level from U.S.C.&G. Bench Mark.

Fort Morgan, Colorado
August 8, 1955

Registered Professional Engineer
State of Colorado

05-075-07304

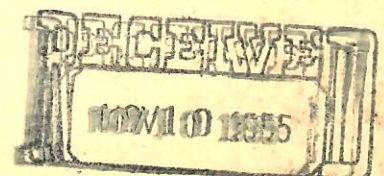

OIL & GAS
CONSERVATION COMMISSION



00823008