


CERTIFICATE OF SURVEY  
for  
Delphern Oil Co.

T12N R55W 6PM.

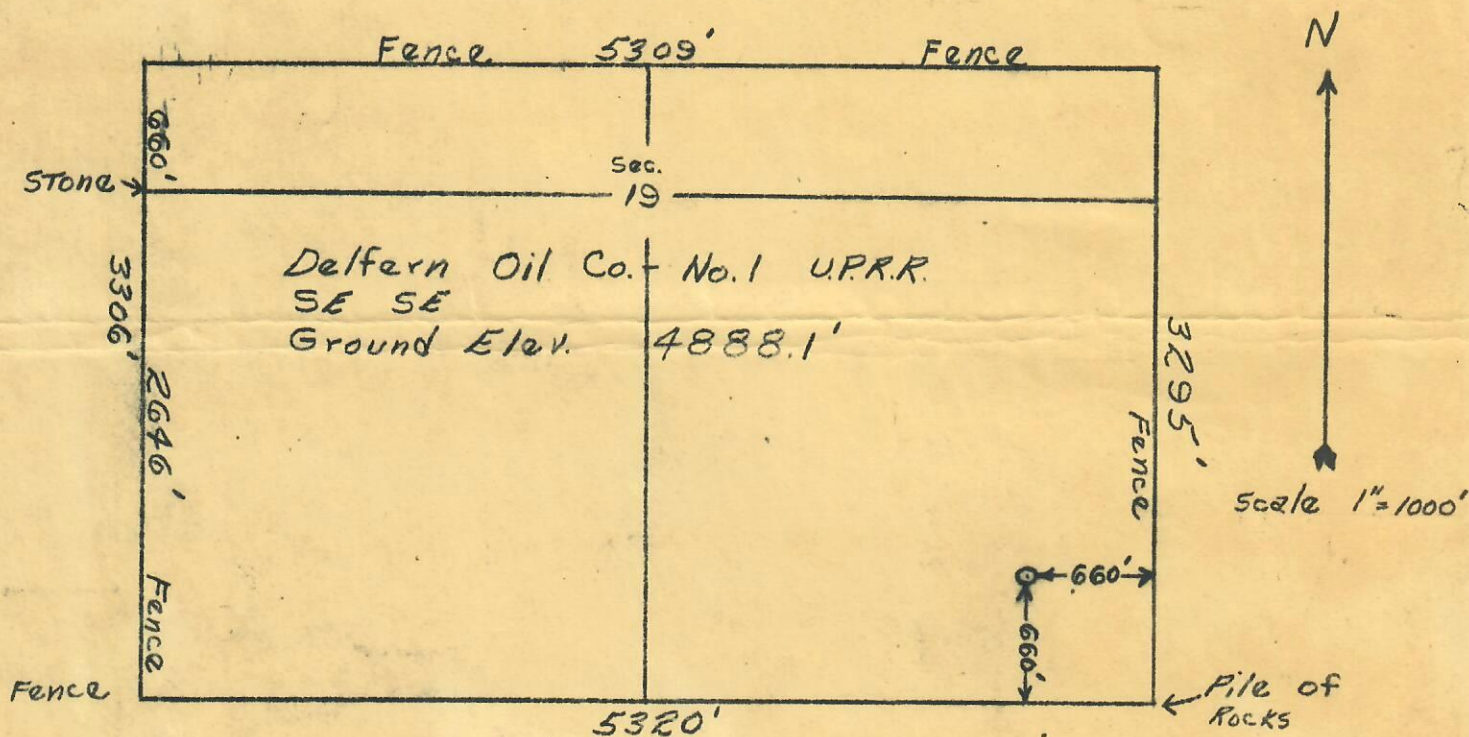

I hereby certify that the above plat is an accurate representation of a correct survey showing the location of Delphern Oil Co. U.P.R.R. No. 1 Oilwell in SE $\frac{1}{4}$ SE $\frac{1}{4}$  Sec. 19 T12N R55W 6PM. Logan County, Colorado. The elevation of the ground at the well is 4888.1 feet above sea level from U.S.C. & G.S. B.M.

Ft Morgan, Colorado  
February 7, 1955.

*Levil*  
Registered Professional Engineer  
State of Colorado



00290813