




P&A Wellbore For State

Well Name: MCCLELLAN 03-32

Land, Original Hole, 9/8/2022 10:05:00 AM

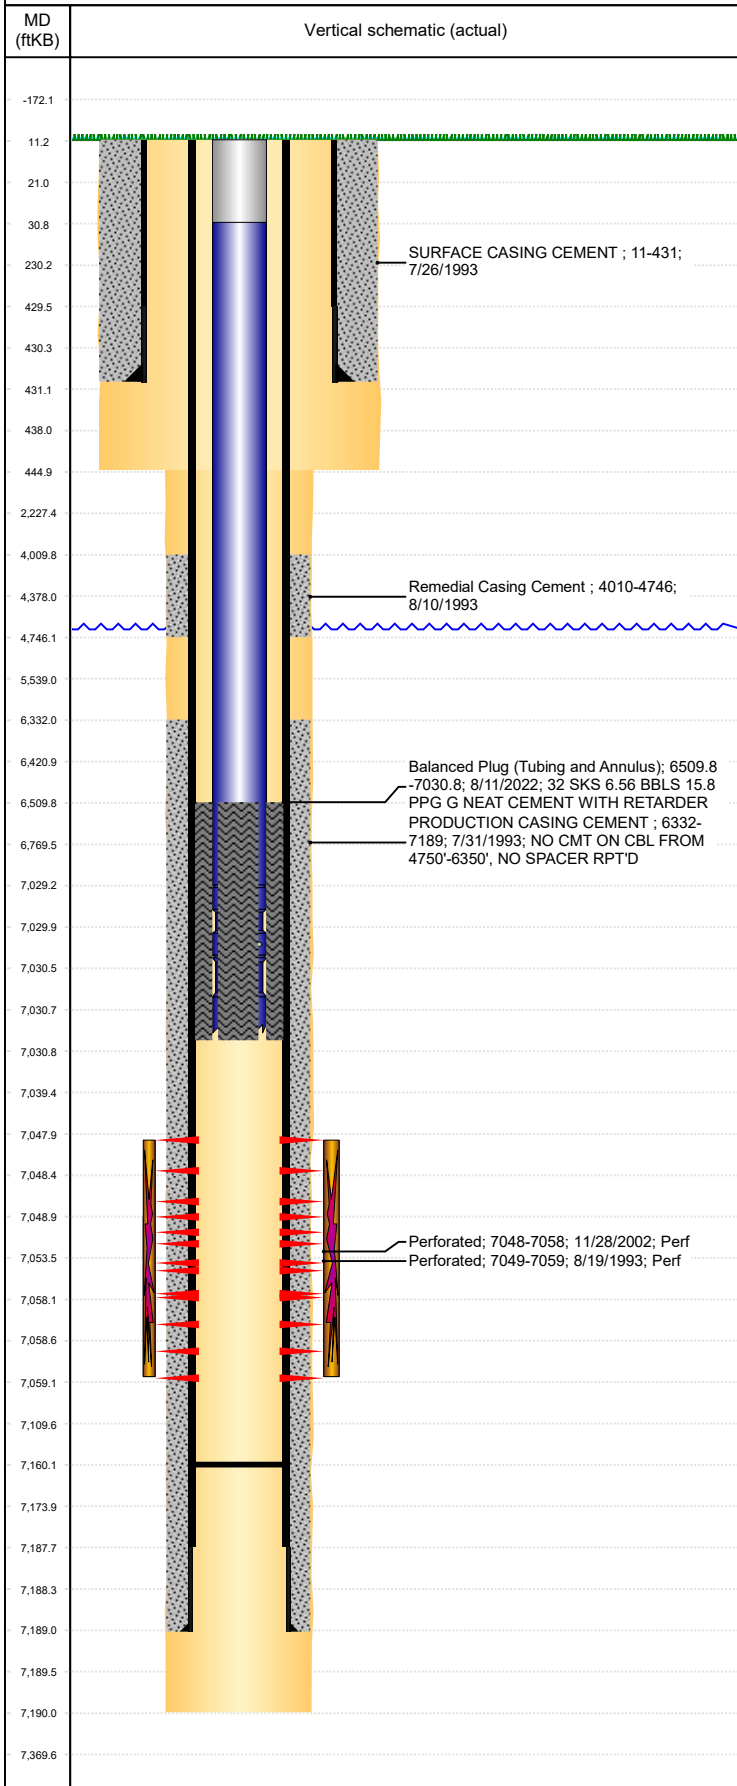

Well Header									
Surface UWI 0512316819			Business Unit Rockies			Gov Auth Dist		Prod Tree Loc Land	
Orig. KB to Gnd (ft) 11.00		Original Spud Date 7/26/1993		Abandon Date		Well Sub-Status TA			High... N
Comment KB DISCREPANCY: LOGS = 4680', ST COMPLETION RPT = 4678'. GL DISCREPANCY: LOGS = 4669', ST COMPLETION RPT = 4668'. PRODUCTION HOLE (BIT#2) DISCREPANCY: DRL RPT = 6 1/4, ST COMPLETION RPT = 7 7/8.									
Surface Location (Congressional)									
Qtr 3 NW	Qtr 4 SW	Section 3	Twnshp 4	Twنش... N	Range 65	Rng E/... W	Latitude (°) 40.34	Longitude (°) -104.6553	
Wellbore Sections									
Section Des			Hole Size (in)			Act Top (ftKB)		Act Btm (ftKB)	
SURFACE			12 1/4			11.0		445.0	
PRODUCTION			6 1/4			445.0		7,190.0	
Casing Strings									
Csg Des			Run Date		OD (in)	Wt/Len (lb/ft)	Grade	Top Depth (MD) (ftKB)	Set Depth (MD) (ftKB)
Surface			7/26/1993		8 5/8	24.00	?	11	431
Production Casing			7/31/1993		4 1/2	15.10	N-80	11	7189
Cement									
Des					Start Date		Top (ftKB)		Btm (ftKB)
SURFACE CASING CEMENT					7/26/1993		11.0		431.0
PRODUCTION CASING CEMENT					7/31/1993		6,332.0		7,189.0
Remedial Casing Cement					8/10/1993		4,010.0		4,746.0
Balanced Plug (Tubing and Annulus)					8/11/2022		6,509.8		7,030.8
Zone Statuses									
Zone Name		Status Date	Status	Fluid Type	Job			Prod Method	
CODELL		3/10/2017	SI		Abandon Well - Temporary, 8/8/2022 08:00				
CODELL		8/11/2022	Closed						
Perforation Data									
Linked Zone			Explosive Type	Entered Shot Total	Top (ftKB)		Btm (ftKB)		Date
CODELL, Original Hole				15	7,048.0		7,058.0		11/28/2002
CODELL, Original Hole					7,049.0		7,059.0		8/19/1993
Stimulation Intervals									
Zone				Start Date		Top (ftKB)		Btm (ftKB)	
CODELL, Original Hole				12/3/2002		7,048.0		7,059.0	
CODELL, Original Hole				8/25/1993		7,049.0		7,059.0	
Other In Hole									
Run Date		Des			Make		OD (in)	Top (ftKB)	Btm (ftKB)
Logs									
Date		Type					Depth Top (MD) (ftKB)		Btm (ftKB)
7/31/1993		COMPENSATED DENSITY					400		7,212.0
7/31/1993		INDUCTION					400		7,212.0
8/5/1993		CBL/CCL/GR					6,200		7,144.0
Plug Back Total Depths									
Date		Type			Com				PBTD (ftKB)
12/4/2002		FILL			CLEAN OUT & LAND TBG				7,160
8/11/2014		FILL							7,160