



99999999

07507443

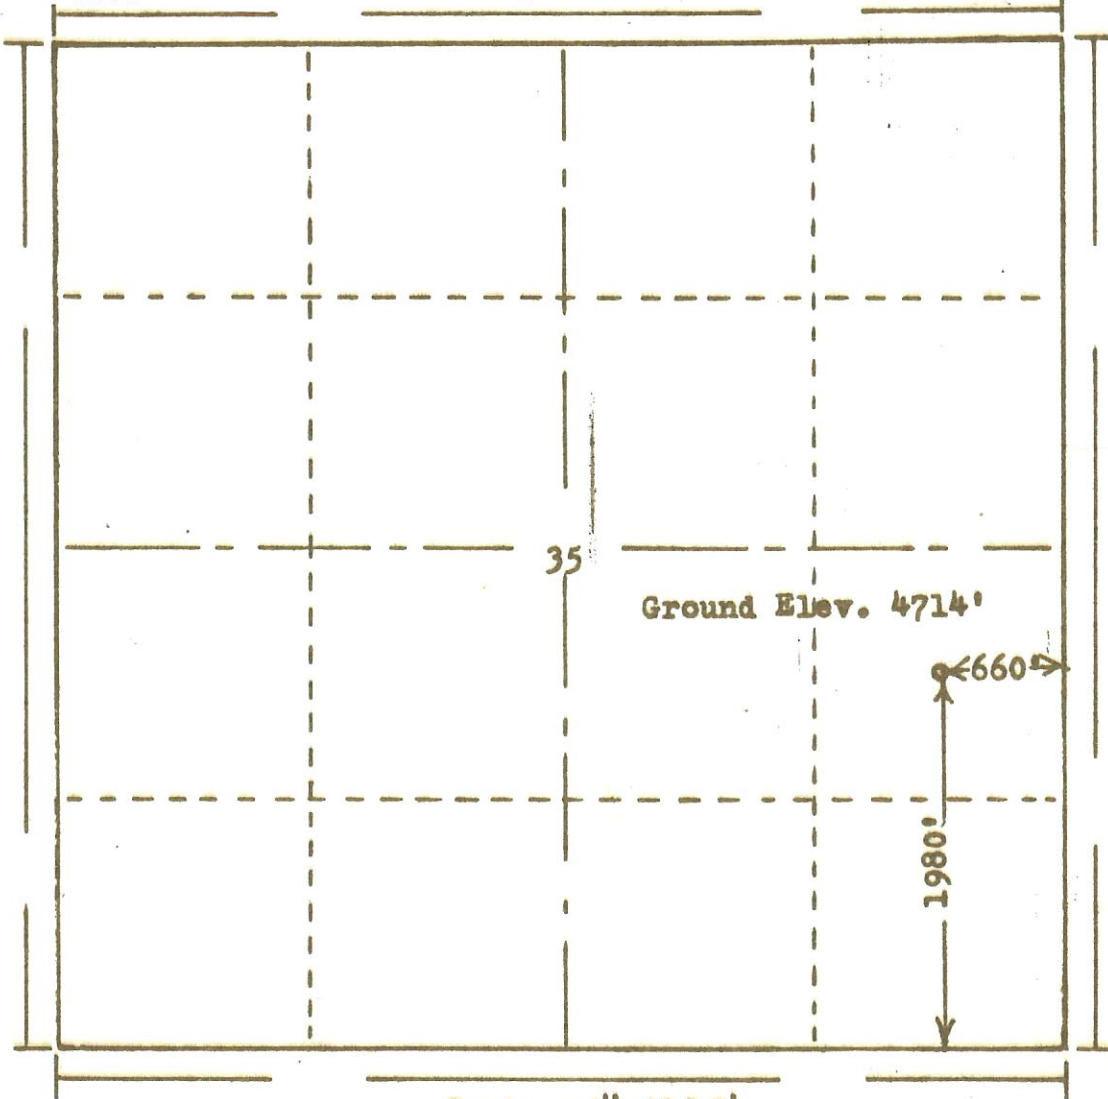
R. 54 W

RECEIVED

DEC 16 1966

COLO. OIL & GAS CONS. COMM

N

T.
12
N

Scale ... 1" = 1000'

Powers Surveyors, Inc. of Denver, Colorado
 has in accordance with a request from Ken Lewis
 for ENBROOK OIL & GAS CO. determined the
 Location of No.1 Herboldscheimer
 to be C NE SE Section 35 Township 12 North
 Range 54 West of the 6th Principal Meridian
 Logan County, Colorado

I hereby certify that this plat is an
 accurate representation of a correct
 survey showing the location of

Date: 12-9-66

Reed L. Holloway
 Licensed Land Surveyor No. 2853
 State of Colorado



00789983

66-507