



00255708

MT HOPE UNIT W-38  
SW/NE SEC 25 T9N R54W


	QTR	QTR	SEC	TWNS	RANGE	PM	NAME	DEPTH	TPERF	BPERF
A	SE	SE	10	090N	0540W	S	RIEKE LOUIE	460		
B	SW	SW	12	090N	0540W	S	SVACINA JIM JR	46		
C	NE	NE	14	090N	0540W	S	SVACINA JAMES			
D	NE	NE	14	090N	0540W	S	SVACINA JAMES JR.	82		
E	NW	NW	15	090N	0540W	S	GONYEA DAVID L	520	255	515
F	NW	NE	16	090N	0540W	S	COLO STATE BOARD LAND COMM	54		
G	SE	NE	22	090N	0540W	S	WILSON HAROLD	113		
H	SE	SE	24	090N	0540W	S	TEXACO INC	412		
I	SE	SE	25	090N	0540W	S	SHELL OIL COMPANY	632		
J	NE	SW	26	090N	0540W	S	KESTER LEWIS H	600		
K	NE	SE	27	090N	0540W	S	BANEY ROBERT	574		
L	SE	NE	32	090N	0540W	S	LUFT ALBERT E.	80		
M	SW	SE	32	090N	0540W	S	RIEKE LLOYD			
N	NE	NW	33	090N	0540W	S	KOENIG V C	55		
O	SW	NE	34	090N	0540W	S	WALTERS KATHERINE ESTATE	240		
P	SW	NE	34	090N	0540W	S	WALTERS KATHERINE ESTATE	200	100	200
Q	SW	SE	34	090N	0540W	S	KOENIG MILDRED H & V C			
R	SE	NW	36	090N	0540W	S	CO BRD LND COMMISSIONERS	600		
S	SE	NW	36	090N	0540W	S	CO BRD LND COMMISSIONERS		300	460
T	NE	NW	04	090S	0540W	S	EWING W R			

Letter=Choice | F10=Mark 1 | PgUp/PgDn=±20 | UpAr/DnAr =±1 | Esc=Quit

0 = WATER WELL

## OIL AND GAS WELL/WATER WELL

## BASE PLAT

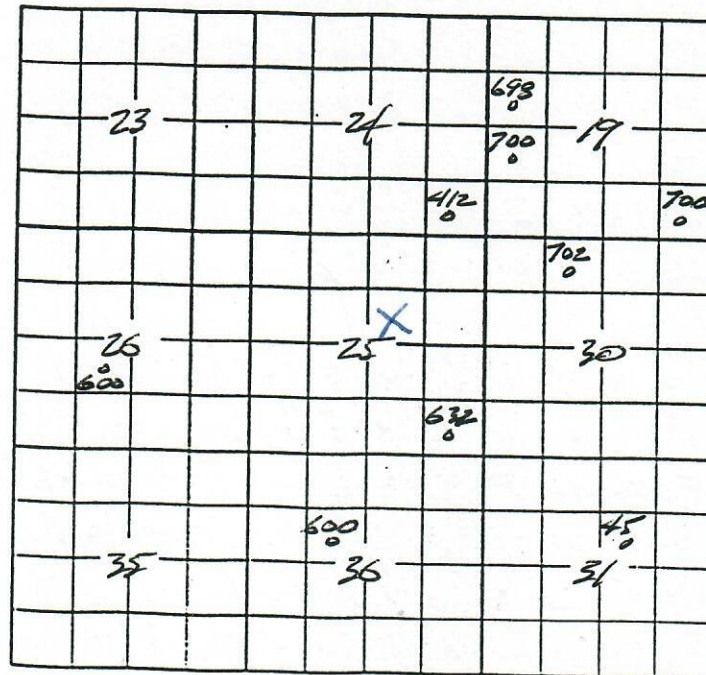



D-8720

# SCHLUMBERGER WELL SURVEYING CORPORATION

REGISTERED TEXAS



## Electrical Log

COUNTY: LOGAN FIELD OR LOCATION: MT. HOPE LOCATION: SEC. 25-21-54W WELL: GREEN #A-17 COMPANY: TEXAS COMPANY	COMPANY: TEXAS COMPANY	Location of Well    SW SW NE  Elevation: D. F. 4212 K.B.L. 4214 or G.L. 4202
	WELL: GREEN #A-17	
	FIELD: MT. HOPE	
	LOCATION: SEC. 25-21-54W	
	COUNTY: LOGAN	
STATE: COLORADO		
FILING No. D-8720		

RUN NO.	ONE				
Date	7/21/53				
First Reading	5082				
Last Reading	187				
Footage Measured	4895				
Csg Shoe Schlum	187				
Csg Shoe Driller	187				
Max. Depth Reached	5082				
Bottom Driller	5080				
Depth Datum	KB				
Mud Nature	CLAY				
" Density	9.8				
" Viscosity	75				
" Resistivity	3.52 @ 62°F	@ 62°F	@ 62°F	@ 62°F	@ 62°F
" Resistivity BHT	1.6 @ 136°F	@ 136°F	@ 136°F	@ 136°F	@ 136°F
" pH	@	@	@	@	@
" Water Loss	CC/30 Min.	CC/30 Min.	CC/30 Min.	CC/30 Min.	CC/30 Min.
Maximum Temp. °F	136				
Bit Size	9" - ID				
Spacings—AM	64"				
A	518"				
AO	72"				
E.S. Rig Time	791 SIB				
Truck No.	CHRYSLER				
Recorded By	ICPIL				
Witnessed By					

### REMARKS

MUD SAMPLE FROM FLOW LINE.

## A RILEY REPRODUCTION

Reg. No. 579892

SPONTANEOUS-POTENTIAL  
millivolts

DEPTH

RESISTIVITY  
-ohms. m<sup>2</sup>/m.

4927  
4214  
713

5015  
4214  
801



0 AMPLIFIED NORMAL 10

CSG.  
187

