


This location was



00241552


1964

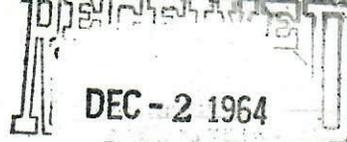

DEC - 2 1964

OIL & GAS
CONSERVATION COMMISSION

R. 55 W

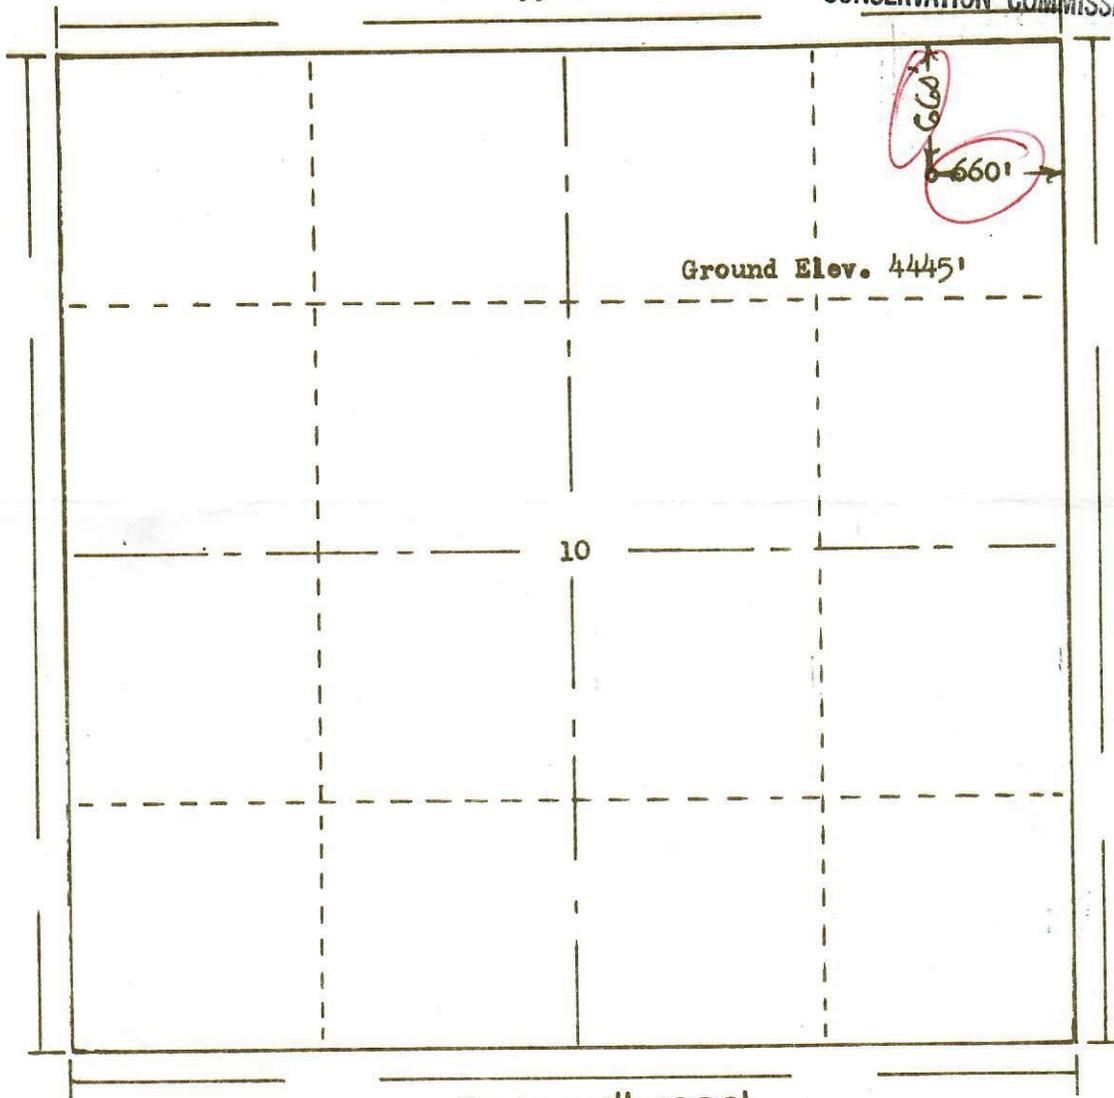

T.
9
N

Scale ... 1" = 1000'

Powers Surveyors, Inc. of Denver, Colorado
 has in accordance with a request from **Mr. Gross**
 for **DeKALB AGRICULTURAL ASS'N** determined the
 Location of **No. 1 Agnes L. Kinzie**
 to be 660' FN & 660' FE Section 10 Township 9 North
 Range 55 West of the 6th Principal Meridian
 Logan County, Colorado

64-534

I hereby certify that this plat is an accurate representation of a correct survey showing the location of

Bee J. Holloway

Licensed Land Surveyor No. 2853
State of Colorado

11-28-64

DVR	
WRS	
HHM	
JAM	
FJP	
JJD	✓
FILE	