14

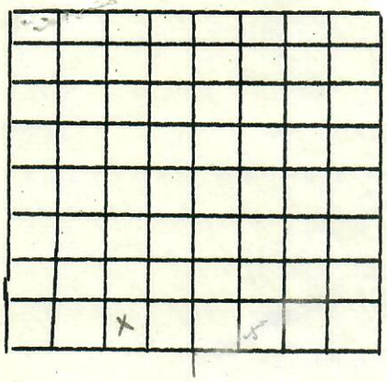

Locate
Well
Correctly

Koenig-Ashby #2

OFFICE OF STATE OIL INSPECTOR
Oil and Gas Conservation
Department

- - -

LOG OF OIL AND GAS WELL

00819402

Company British-American Oil Prod. Co. Address Casper, Wyoming
~~State or~~ Patented Koenig-Ashby Field Yenter Block State Colorado
Well No. 2 Sec. 34 T. 9 N. R. 54 W Meredian 6 County Logan
Location 330 Ft. (N) of So. Line and 990 Ft. (W) of E line of SL Elevation 4376'
(Derrick floor relative to sea level)

The information given herewith is a complete and correct record of the well and all work done thereon so far as can be determined from all available records.

Signed C. Wm. Evelyn, Jr.
Date 2-20-51 Title District Superintendent

The summary on this page is for the condition of the well as above date.
Commenced drilling 12-13, 1950 Finished Drilling 1-2 1951

OIL SANDS OR ZONES

No. 1, from 5227 to 5234 No. 4, from to
No. 2, from to No. 5, from to
No. 3, from to No. 6, from to

IMPORTANT WATER SANDS

No. 1, from to No. 3, from to
No. 2, from to No. 4, from to

CASING RECORD

Size	Weight per ft.	Threads per inch	Make	Amount	Kind of Shoe	Cut & Pulled from	Perforated From	Perforated to	Purpose
8 5/8"	32#	10 V	H-40	200'	None				Surface Csg.
5½"	15.5#	8 Rd.	J-55	5226'	Baker				Oil String Csg.

MUDDING AND CEMENTING RECORD

Size	Where Set	No. Sacks of Cement	Methods used	Mud Gravity	Amount of Mud Used
8 5/8"	218 KB	150	Halliburton		
5½"	5229 KB	125	Halliburton		

PLUGS AND ADAPTERS

Heaving plug-Material Length Depth Set
Adapters-Material Size

SHOOTING RECORD

Size	Shell Used	Explosive Used	Quantity	Date	Depth Shot	Depth Cleaned Out

TOOLS USED

Rotary Tools used from 0 ft. to 5234 ft. and from ft. to ft.
Cable tools were used from ft. to ft. and from ft. to ft.

DATES

2-20 1951 Put to producing 1-27 1951

The production for the first 24 hours was barrels of fluid of which 189 Bbls. % was oil, 92 Bbl. % emulsion; % sediment. Gravity Be, Est. 40 API
If gas well, cu. ft. per 24 hours Gallons gasoline per 1,000 cu. ft. of gas . Rock Pressure, lbs. per sq. in 1400#

EMPLOYES

Herndon Drilling Co. Driller F. L. Elliott, Driller
Emil Baker Driller J. H. Williams, Driller

FORMATION RECORD

From	To	Total Feet	Formation
Surface	2035		Shale
2035	2344		Shale & Bentonite
2344	4620		Shale & Shells
4620	5040		Shale & Lime
5040	5234		Sand & Shale

5223' Top of "J" Sand