



99999999

REC

AUG-4 1964


AUG 3 1964

R.54 W

OIL & GAS
CONSERVATION COMMISSION



0506294

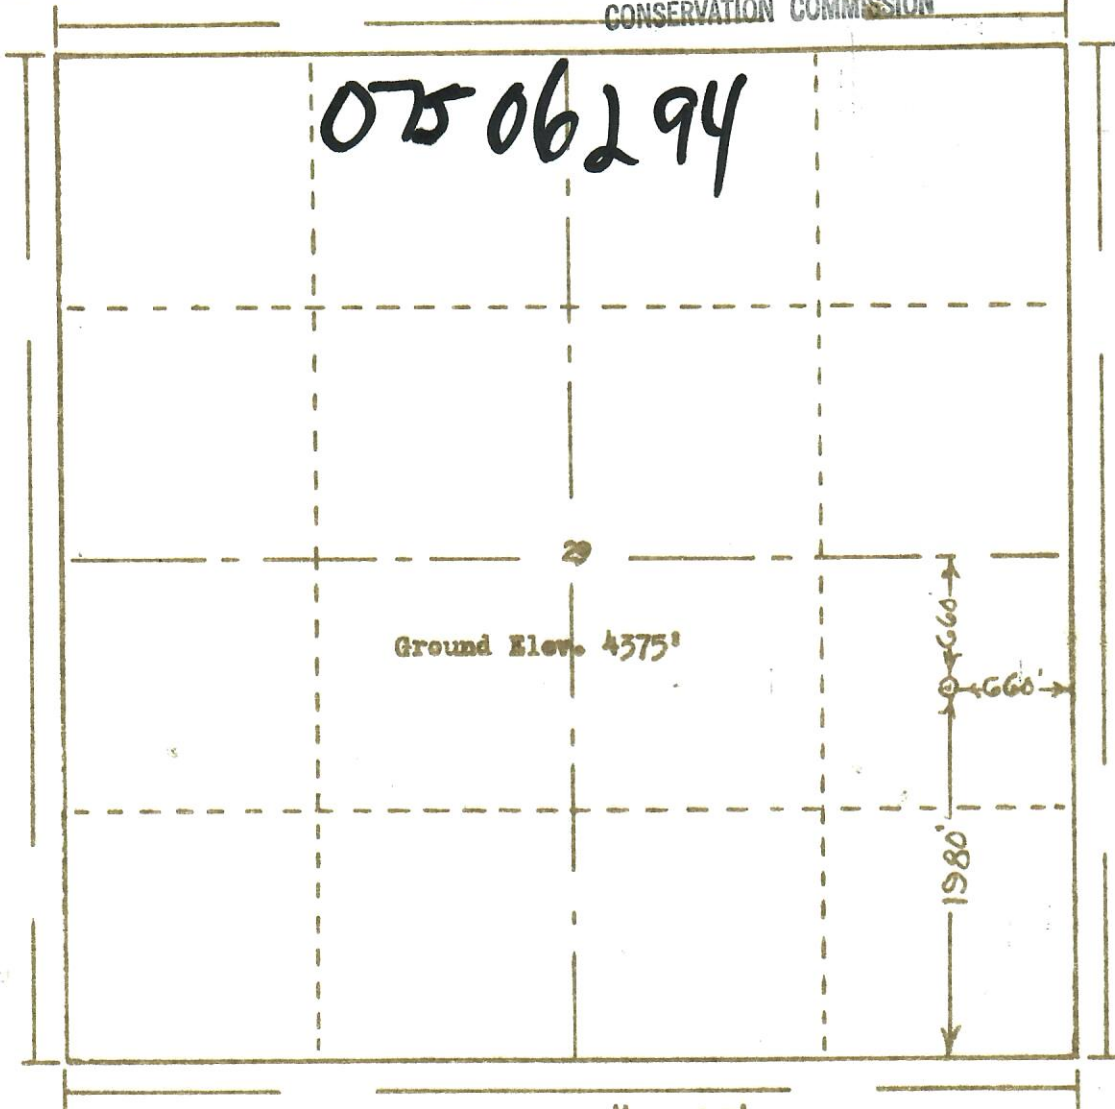

T.
9
N

Scale ... 1" = 1000'

Powers Surveyors, Inc. of Denver, Colorado
has in accordance with a request from Florence Johnston
for KNIGHT & MILLER—ROBT. SCHULEIN—GAGE OIL codetermined the
Location of No.1 Warnecke
to be 0 NE SE Section 29 Township 9 North
Range 54 West of the 6th Principal Meridian
Logan County, Colorado

I hereby certify that this plat is an
accurate representation of a correct
survey showing the location of

OK
Haw

Bill T. Holloway

Licensed Land Surveyor No. 2853
State of Colorado

7-29-64



00819248