

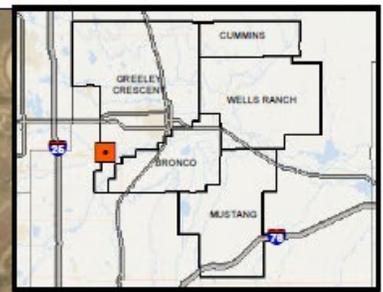


# STROH O 2-17

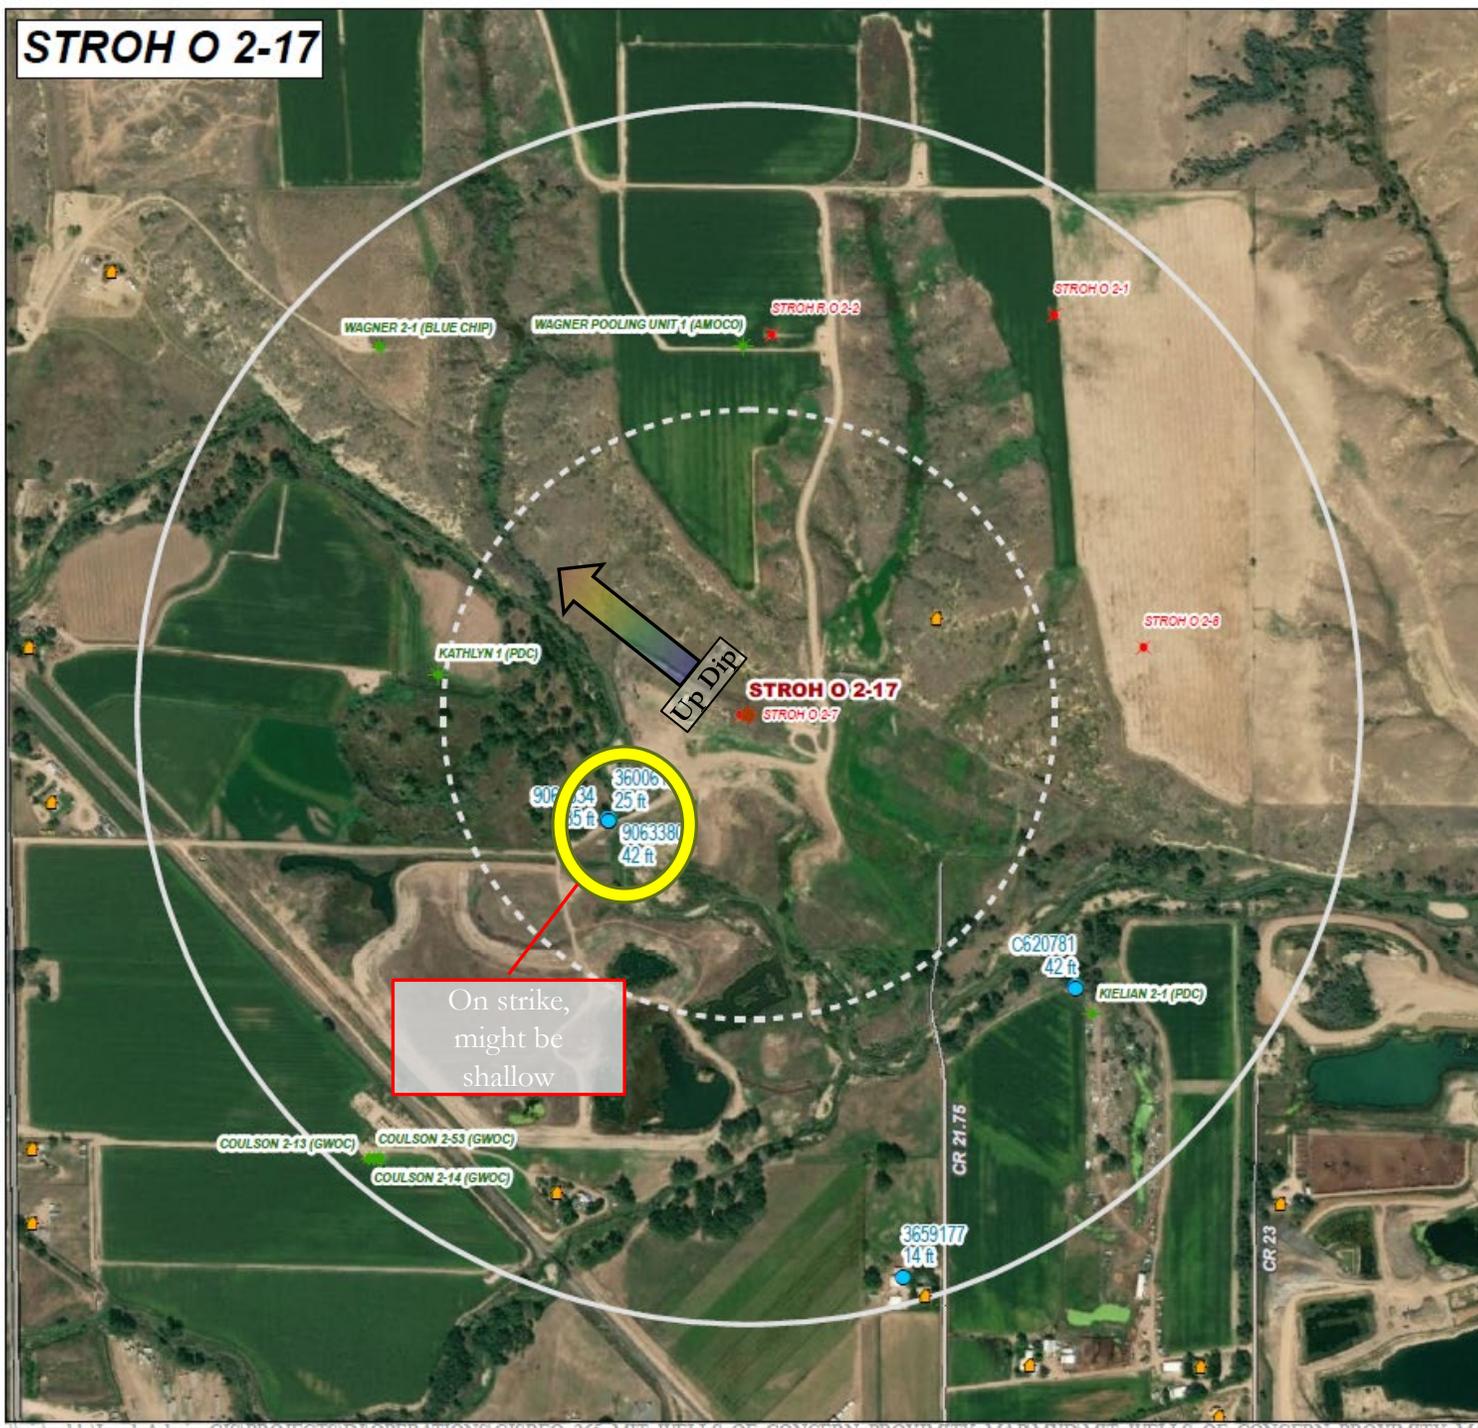

- MIT Well
  - MIT Well (1/4 Mile Buffer)
  - MIT Well (1/2 Mile Buffer)
  - CDWR Water Well (Receipt No./Depth of Well)
  - Address Point
- | Noble Wells           | Competitor Wells |
|-----------------------|------------------|
| Drilling              | Drilling         |
| P&A                   | P&A              |
| Producing             | Producing        |
| Shut-In               | Shut-In          |
| Waiting on Completion | Approved Permit  |
| Approved Permit       |                  |

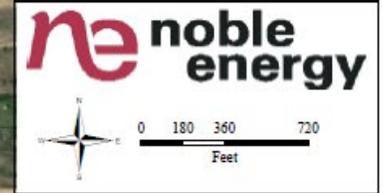

## MIT Well Proximity Map

Weld County, Colorado

CSR: NAD 1983 UTM Zone 13N

Revised by: THOMASDOUGLASS      Date: 12/10/2018

Disclaimer: This map has been carefully compiled through different data sources available to Noble Energy Inc. While the information is held to the highest degree of accuracy possible, its uses are for informative purposes only and therefore is not suitable for legal, engineering, and surveying purposes. Noble Energy Inc. does not guarantee nor assumes responsibility for misuse or misinterpretation of any information present. Recipient agrees not to reproduce, distribute, nor digitize without expressed consent from Noble Energy inc. and its affiliates.