




RECEIVED

MAY - 7 1969

R. 55W

COLO. OIL & GAS CONS. COMM.

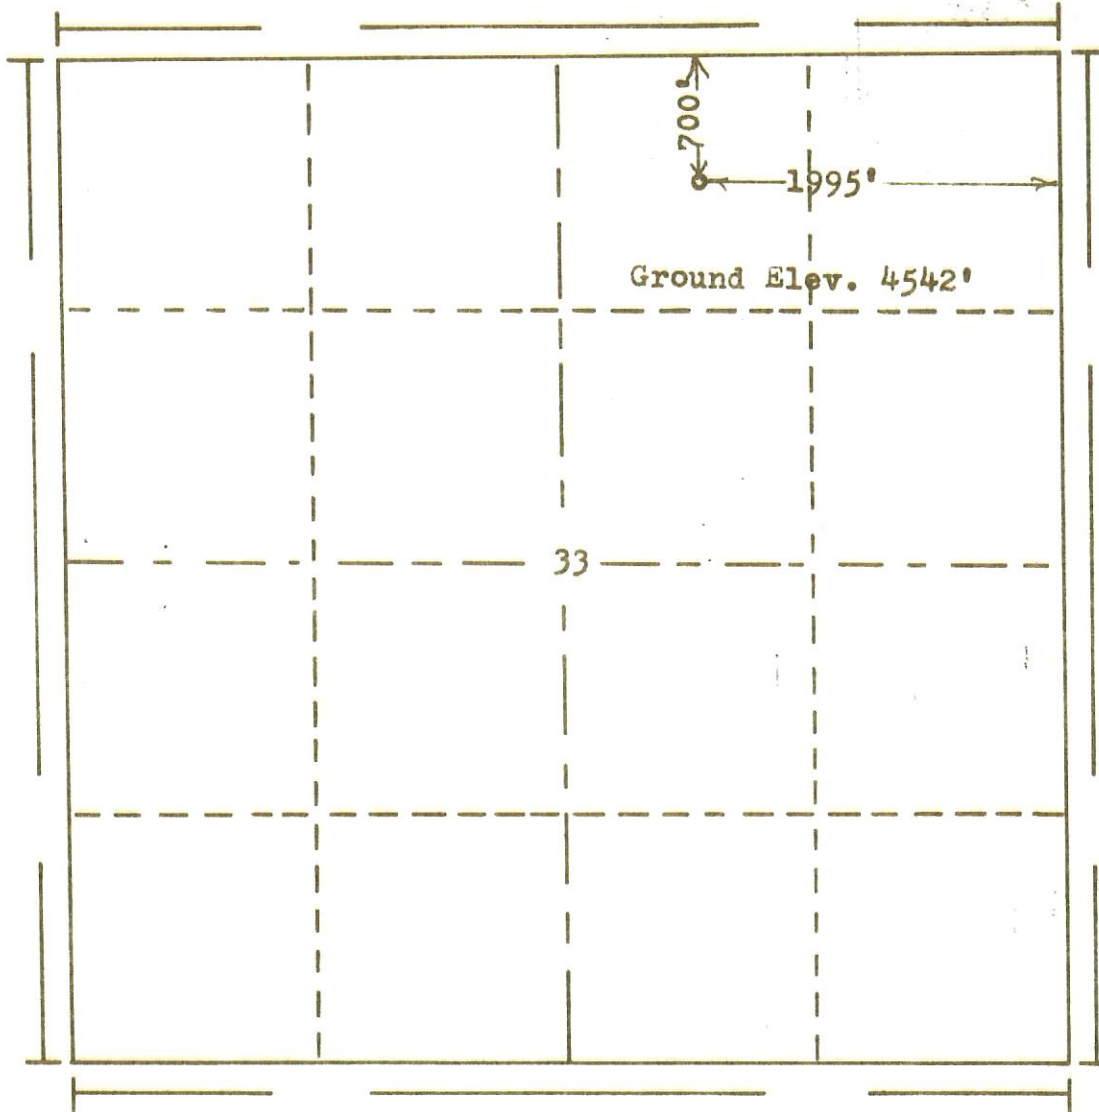

Scale... 1" = 1000'

Powers Elevation Company, Inc. of Denver, Colorado  
has in accordance with a request from Mr. Wilson  
for Petroleum Inc.

determined the location of No.2 Wilson Heirs  
to be CNW NE Section 33 Township 12N  
Range 55W of the 6th Principal Meridian  
Logan County, Colorado

I hereby certify that this plat is an  
accurate representation of a correct  
survey showing the location of

Date: 4-28-69

Betty G. Holman  
Licensed Land Surveyor No. 2853  
State of Colorado

69-200