


RECEIVED •

APR - 4 1969

COLO. OIL & GAS CONS. COMM.

R. 55 W.

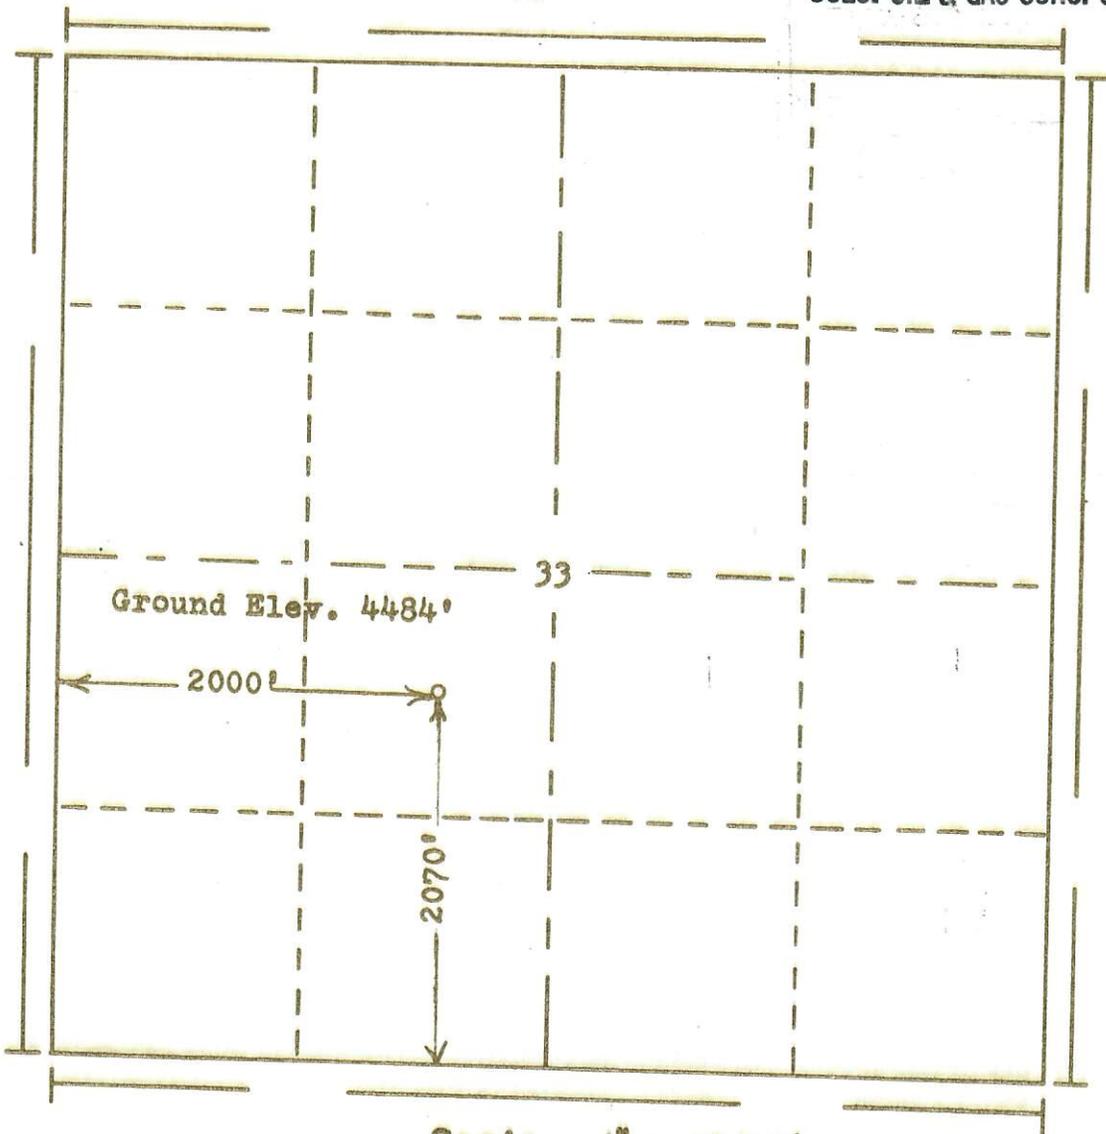

T.  
12  
N

Scale... 1" = 1000'

Powers Elevation Company, Inc. of Denver, Colorado  
 has in accordance with a request from Mr. Phillips  
 for Petroleum Inc.  
 determined the location of No. 2 Nelson "O"  
 to be C NE SW Section 33 Township 12 North  
 Range 55 West of the 6th Principal Meridian  
Logan County, Colorado



00290987

I hereby certify that this plat is an  
 accurate representation of a correct  
 survey showing the location of

Date: 3-8-69

Brie J. Holloman  
 Licensed Land Surveyor No. 2853  
 State of Colorado