




R. 55W

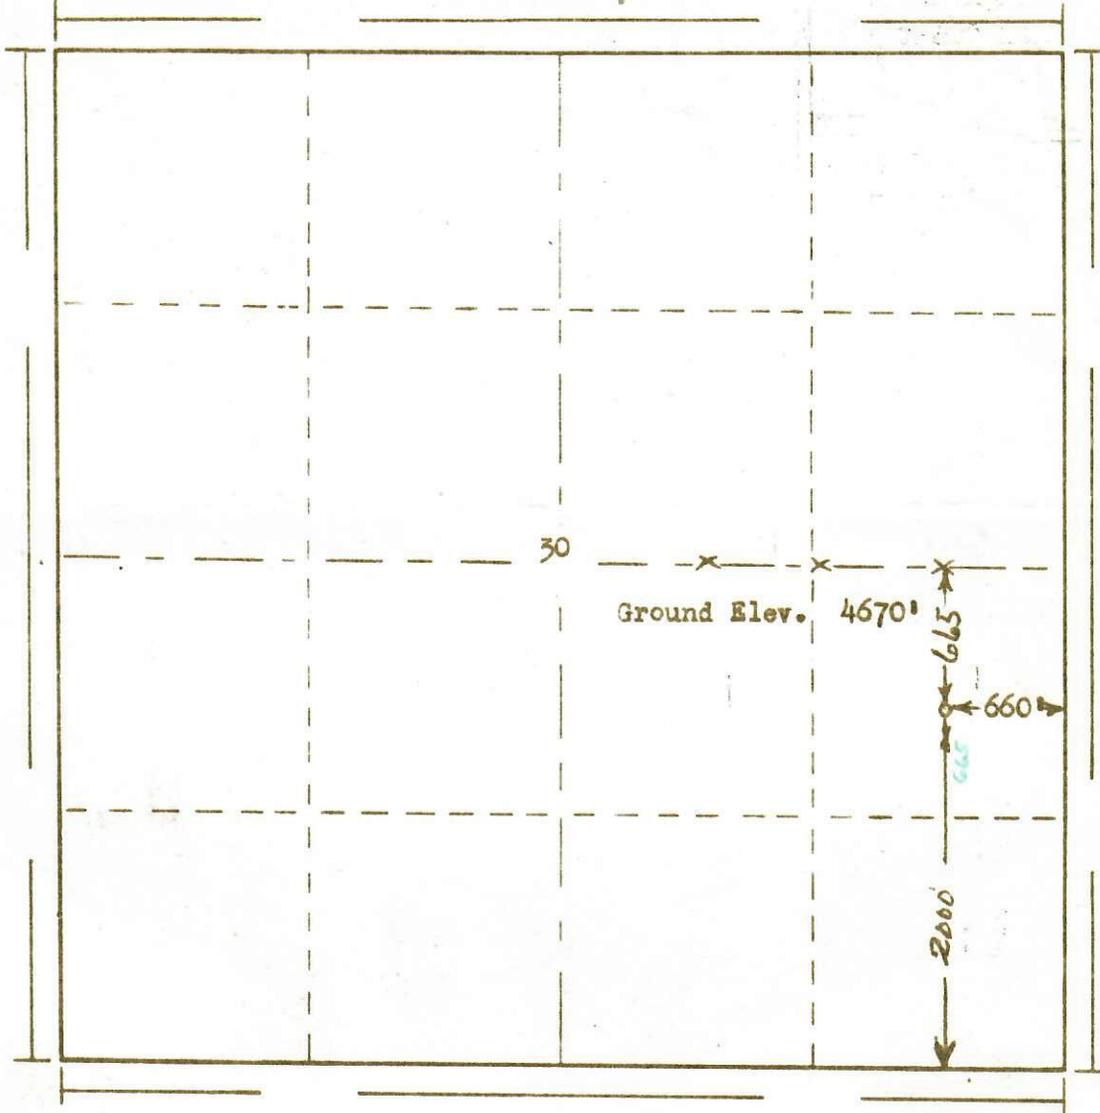

T. 12 N

Powers Surveyors, Inc. of Denver, Colorado

has in accordance with a request from Bill Palmer
 for Tol-Tek Drlg. Co. & H.B. Mabee Co. determined the
 Location of No.1 Peavy
 to be CNE SE Section 30 Township 12N
 Range 55W of the 6th Principal Meridian
 Logan County, Colorado

DISTRICT
 JUL 30 1963
 CONSERVATION COMMISSION

The above Plat shows the location of the well site in said section.

05-075 -07255

POWERS SURVEYORS, INC.

by: *Clay L. Holloway*
District Engineer



Date: 6-19-63