




00241575

RECEIVED
SEP 30 1964

R. 55W

OIL & GAS
CONSERVATION COMMISSION

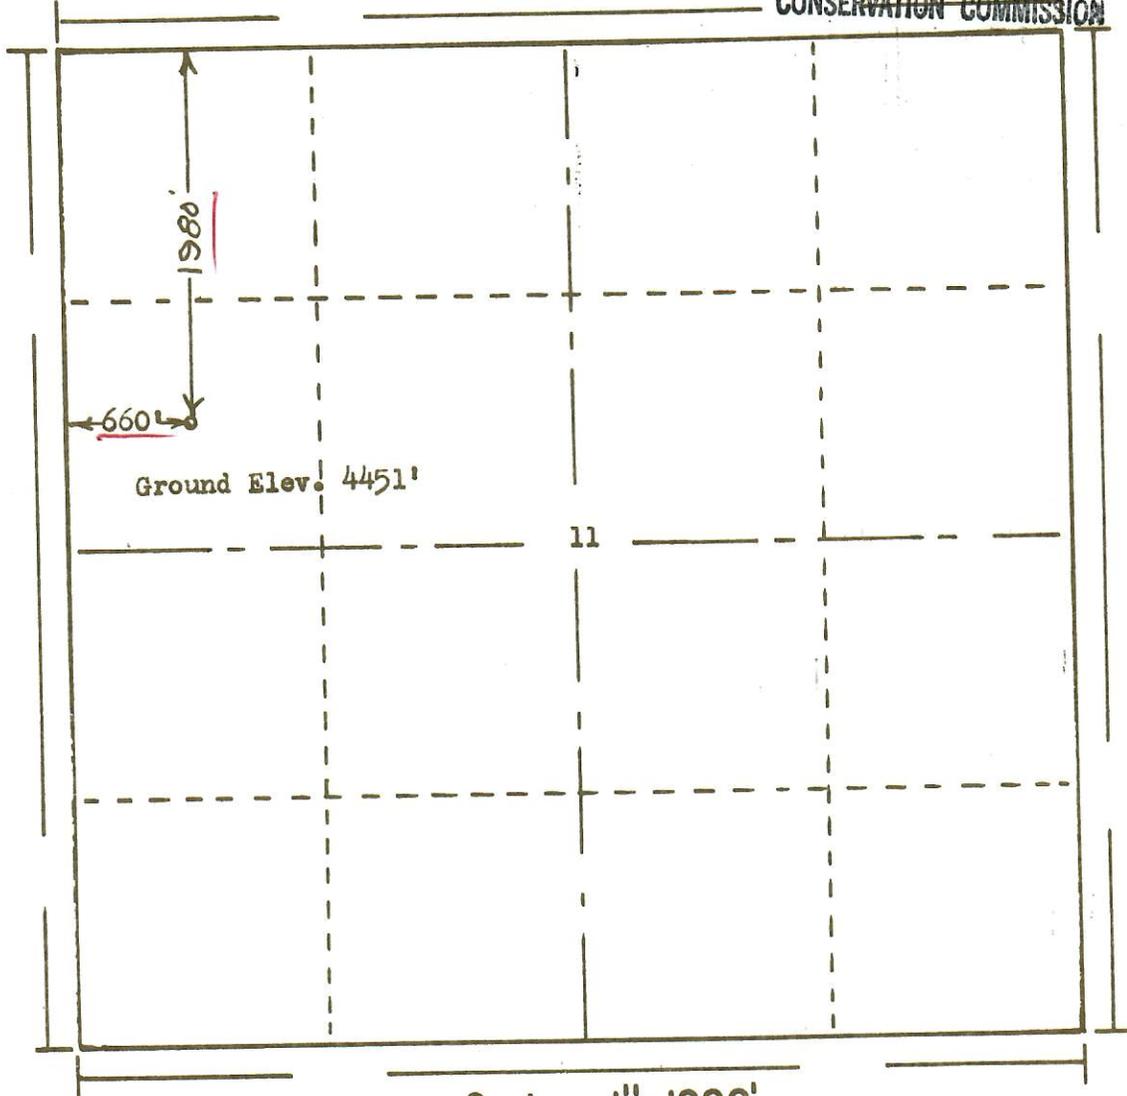

T.
9
N

Scale ... 1" = 1000'

Powers Surveyors, Inc. of Denver, Colorado
 has in accordance with a request from **Mr. Gross**
 for **DeKalb Agricultural Association, Inc.** determined the
 Location of **No. 1 Mathewson**
 to be QSW NW **Section 11** Township 9N
 Range 55W of the 6th Principal **Meridian**
Logan County, Colorado

I hereby certify that this plat is an
 accurate representation of a correct
 survey showing the location of

Bio. J. Holloway
 Licensed Land Surveyor No. 12853
 State of Colorado

9-21-64

DVR	
WRS	
HHM	
JAM	
FJP	
JJD	✓
FILE	