



CERTIFICATE OF SURVEY
Logan County, Co.
for
Ryan Oil Co.

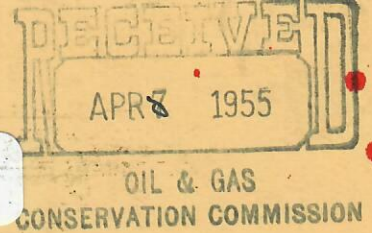


T12N R55W 6PM

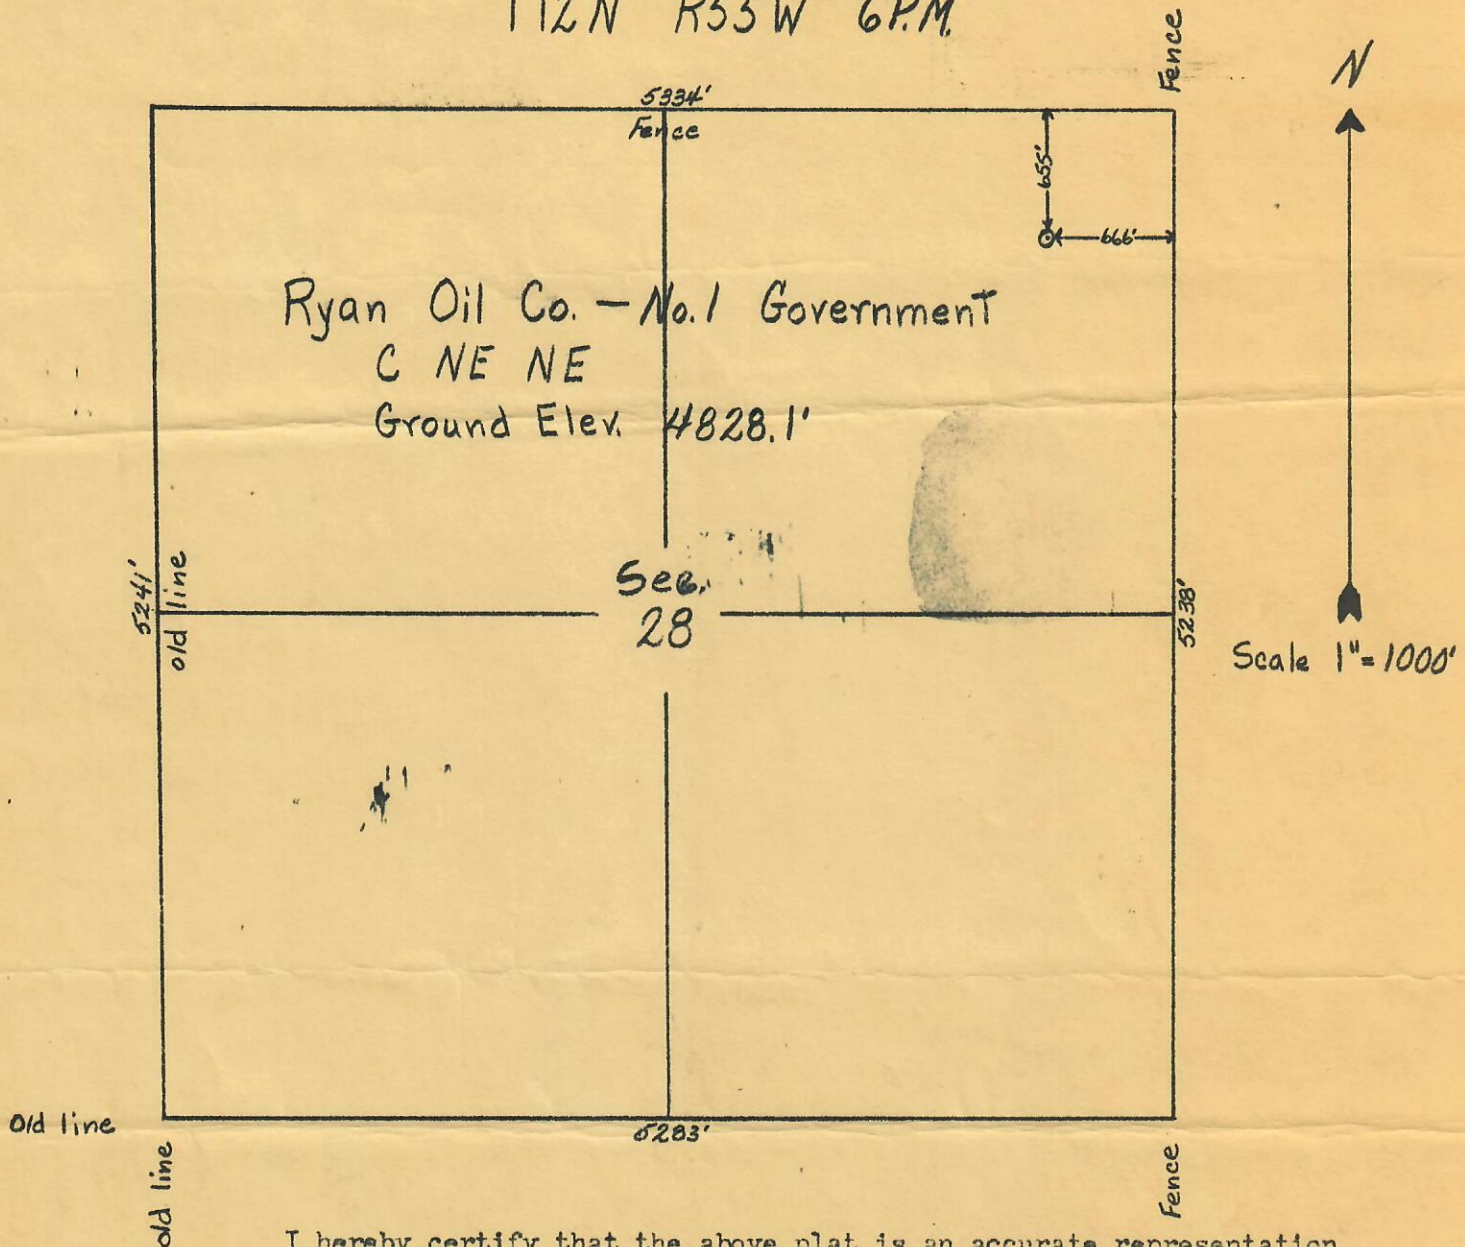

I hereby certify that the above plat is an accurate representation of a correct survey showing the location of Ryan Oil Co.- Government No.1 Oilwell in NENE Sec. 28 T12N R55W 6PM. The elevation of the ground at the stake is 4828.1 feet above sea level from U.S.C. & G. Bench Mark.

Fort Morgan, Colorado
April 1, 1955

Robert J. Harrison
Registered Professional Engineer
State of Colorado

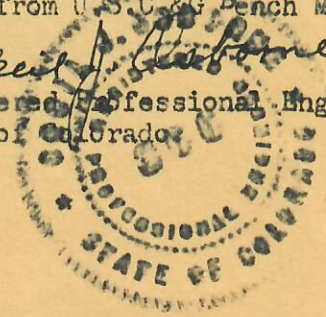

L-14 6200