


RECEIVED

FEB 14 1969

R. 55W

COLO. OIL & GAS CONS. COMM.

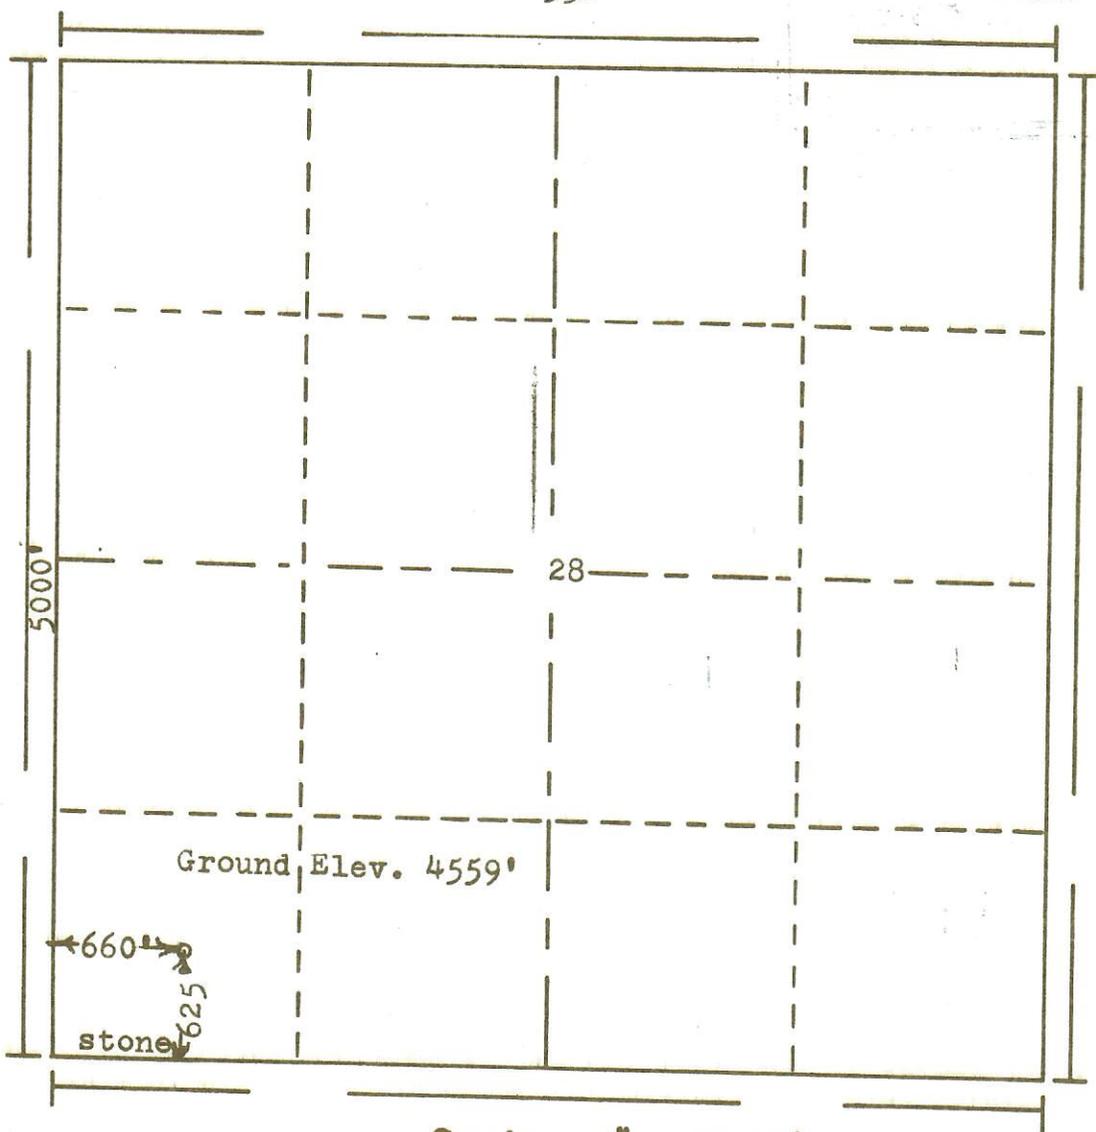

T. 12 N

Scale... 1" = 1000'

Powers Elevation Company, Inc. of Denver, Colorado has in accordance with a request from Mr. Phillips for Petroleum Inc.

determined the location of No. 2 Nelson "N" to be CSW SW Section 28 Township 12N Range 55W of the 6th Principal Meridian Logan County, Colorado

I hereby certify that this plat is an accurate representation of a correct survey showing the location of



00290874

Date: 2-6-69

Bill J. Holloway
Licensed Land Surveyor No. 2853
State of Colorado