


RECEIVED

FEB 13 1969

COLO. OIL & GAS CONS. COMM.

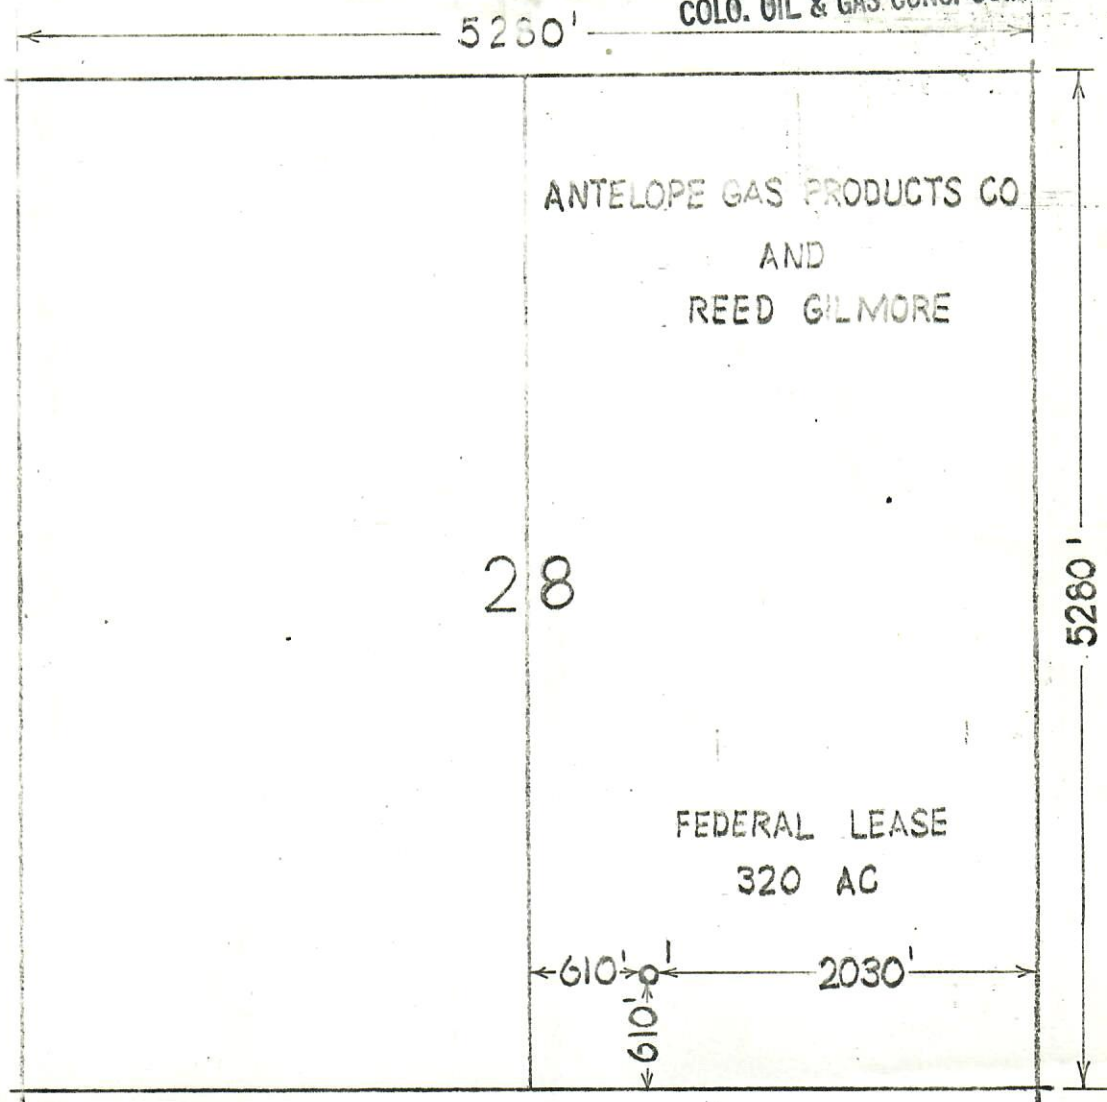

LOCATION PLAT

ANTELOPE GAS PRODUCTS CO AND REED GILMORE

FEDERAL LEASE - WELL NO 1

610' FWL AND 610' FSL OF EAST-HALF

SEC 28 T-12-N R-55-W

LOGAN CO COLORADO



00290899

2-11-69

SCALE 1" = 1000'