


RECEIVED

FEB 14 1969

R. 55 W.

COLO. OIL & GAS CONS. COMM.

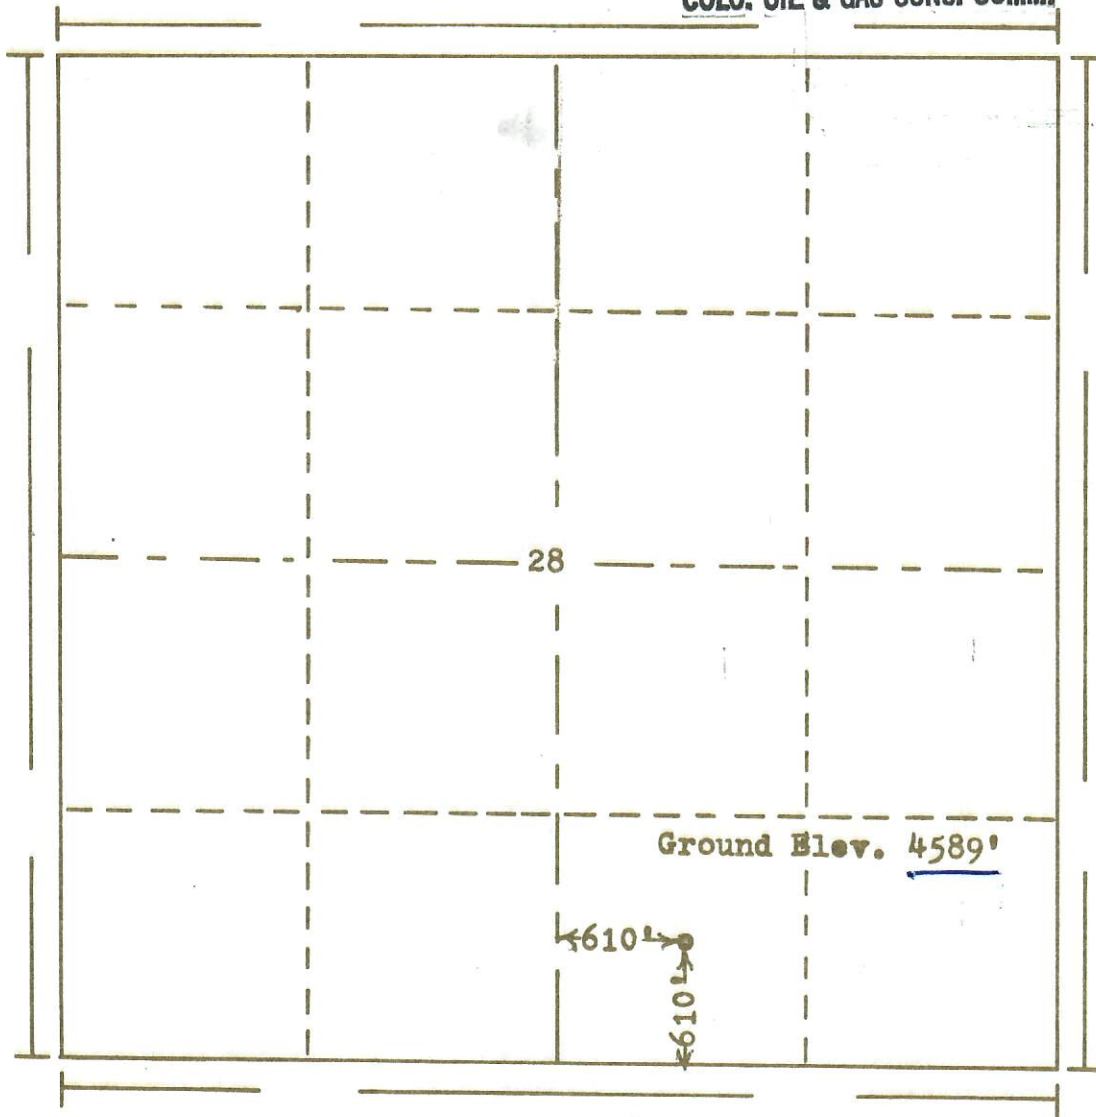

Scale... 1" = 1000'

Powers Elevation Company, Inc. of Denver, Colorado
has in accordance with a request from Mr. Gilmore
for Antelope Gas Products Co.

determined the location of No. 1 Federal
to be 610'FS & 610'FW of SE $\frac{1}{4}$ Section 28 Township 12 North
Range 55 West of the 6th Principal Meridian
Logan County, Colorado

I hereby certify that this plat is an
accurate representation of a correct
survey showing the location of

Date: 2-10-69



00290900

Bill J. Hollway
Licensed Land Surveyor No. 2853
State of Colorado

69-60