


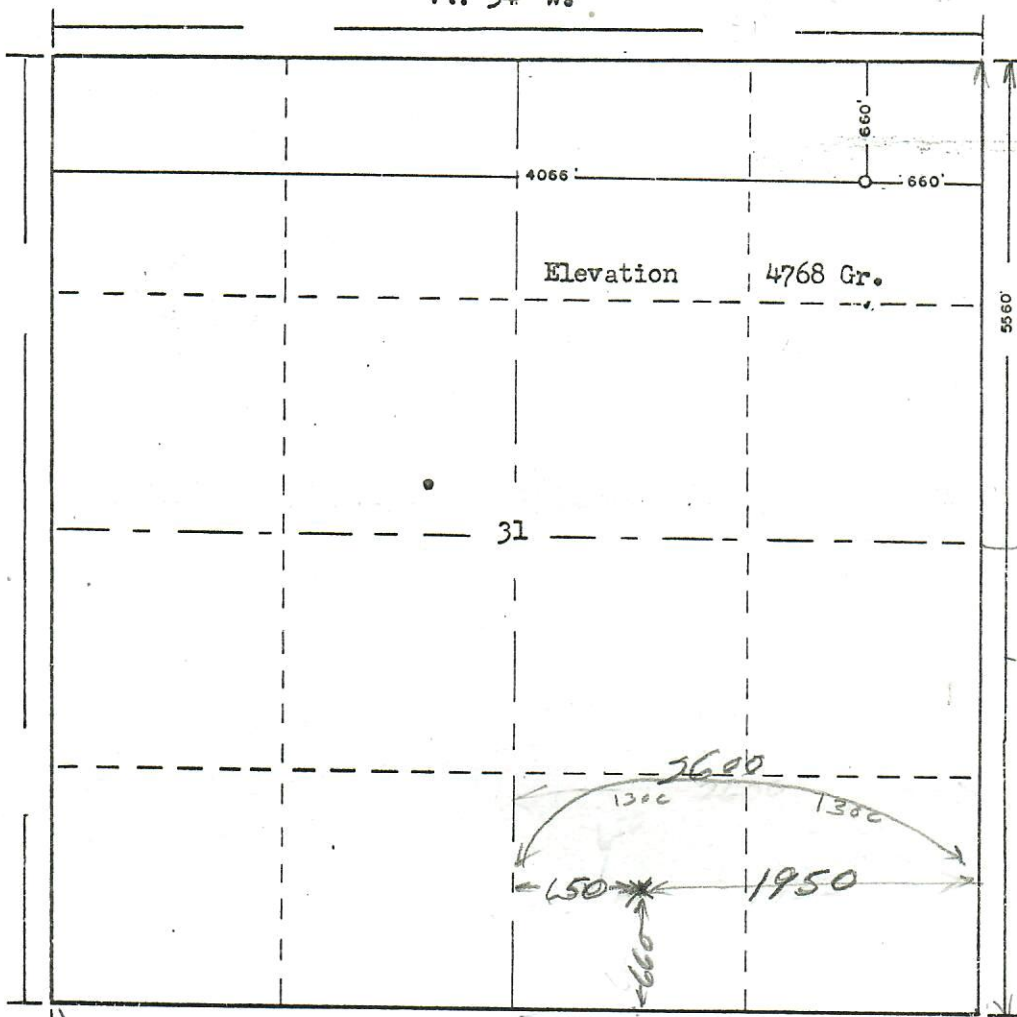

00278596

R. 54 W.

T.
12
N.

4066
660
4726
2613

6'
2600
1300
650

650
1950
2600
1300
650

1750

Powers Elevation Company of Casper, Wyoming
has in accordance with a request from Mr. Jack Brunel
for Anderson & Prichard & Sanford & Rounds determined the

Location of #1 UPRR-Clearman
to be c NE NE Section 31 Township 12 North
Range 3960'W of #2 Hitchcock Meridian
54 West 6th Principal
Logan County, Colorado

The above Plat shows the location of the well site
in said section.

1950
650
2600
✓

71 208

Powers Elevation Company

by: Burr Leibert
Burr Leibert
Registered Land Surveyor

Date: 12-31-55