




RECEIVED

DEC 20 1966

COLO. OIL & GAS CONS. COMM.

R. 54W

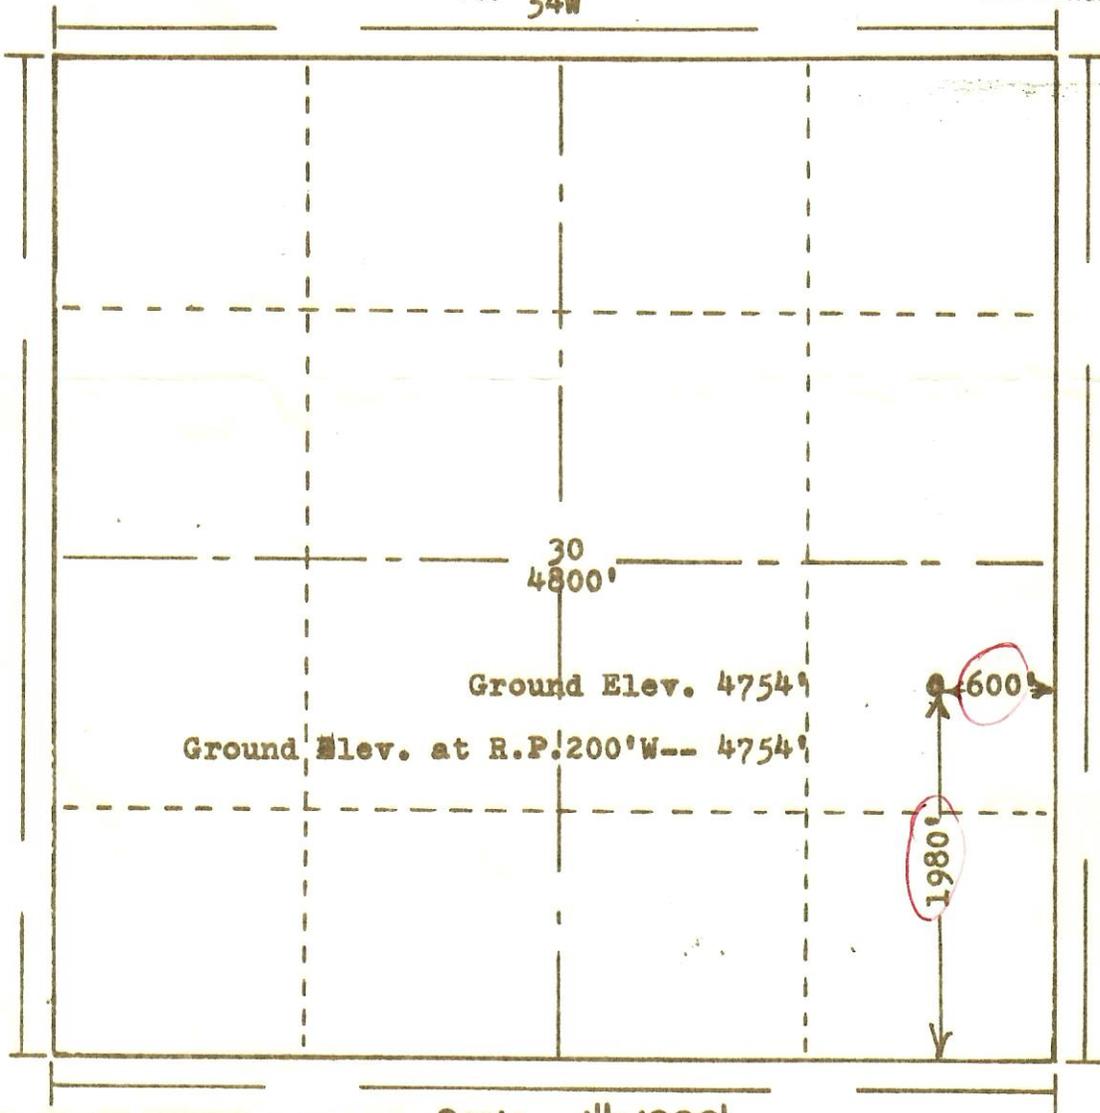

T. 12 N

Scale ... 1" = 1000'

Powers Surveyors, Inc. of Denver, Colorado
 has in accordance with a request from **George Gear**
 for **FUNDAMENTAL OIL CORP.** determined the
 Location of MEIER #1
 to be C NE SE Section 30 Township 12 North
 Range 54 West of the 6th Principal Meridian
 Logan County, Colorado

66-511

I hereby certify that this plat is an
 accurate representation of a correct
 survey showing the location of

Date: 12-9-66

Bee G. Holloway
 Licensed Land Surveyor No. 2853
 State of Colorado

