




OIL AND GAS CONSERVATION COMMISSION
DRY NOTICES AND REPORTS OF WELLS

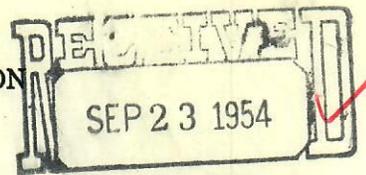

OIL & GAS
CONSERVATION COMMISSION

(Indicate nature of data by checking below)

- Notice of intention to drill (attach plat) _____
- Notice of intention to change plans _____
- Notice of date for test of water shut-off _____
- Report on result of test of water shut-off _____
- Notice of intention to re-drill or repair well _____
- Notice of intention to clean out well _____
- Statement of shooting _____
- Statement of perforating _____
- Notice to pull or otherwise alter casing _____
- Notice of intention to abandon well
- Report of work done on well since previous report _____

Locate Well Correctly

		30	

Notice to do work Land: Fee and Patented
 Report of work done State Lease No. _____

Colorado State Logan County Wildcat Field

#1 (Well No.) Brauer (Lease) NW 1/4 SE 1/4 (1/4 Sec.) 30 (Sec.) T12N (Twp.) R54W (Range) 6th (Meridian)

The Well is located 2273 Ft. (N) of Section Line and 2072 Ft. (E) of Section Line. (W)

The elevation above sea level is 4764 GL Ft.

Details of Plan of Work: (State names of and expected depths to objective sands. Show sizes, weights, and length of proposed casings; indicate mudding jobs, cementing points, and all other important proposed work.)

Plugged and abandoned September 17, 1954, Set 10 sxs cement in surface casing (0-20') Placed metal cap on top of surface casing.

Approved: SEP 23 1954

A. J. Garcia
Director

Date September 21, 1954

Company Falcon Seaboard Drilling Company

Address 722 Patterson Building Denver,

By Zack Taylor

Title Drilling Superintendent

05-075-67264

Submit reports of proposed work, for approval, on this form in Duplicate for patented lands and in Triplicate for school and state lands.

