


Stormin' Norman 1

Pumping

Today - 10/25/2021

API #	Lease ID	Permit #	County	KB	GL	Current production	Sec N/S	Sec E/W	Sec
05-017-07244		91-677	Cheyenne	4314'	4305'		1983' N	672' E	14-14S-47W
Pumping Unit	Motor	State	TD	PBTD	Initial production	Lease N/S	Lease E/W	Blk	
KB = 9'	NAT'L F160-200C-74	CO	5420'	5410'	150 BOPD 20 MCFD 24 BWPD				

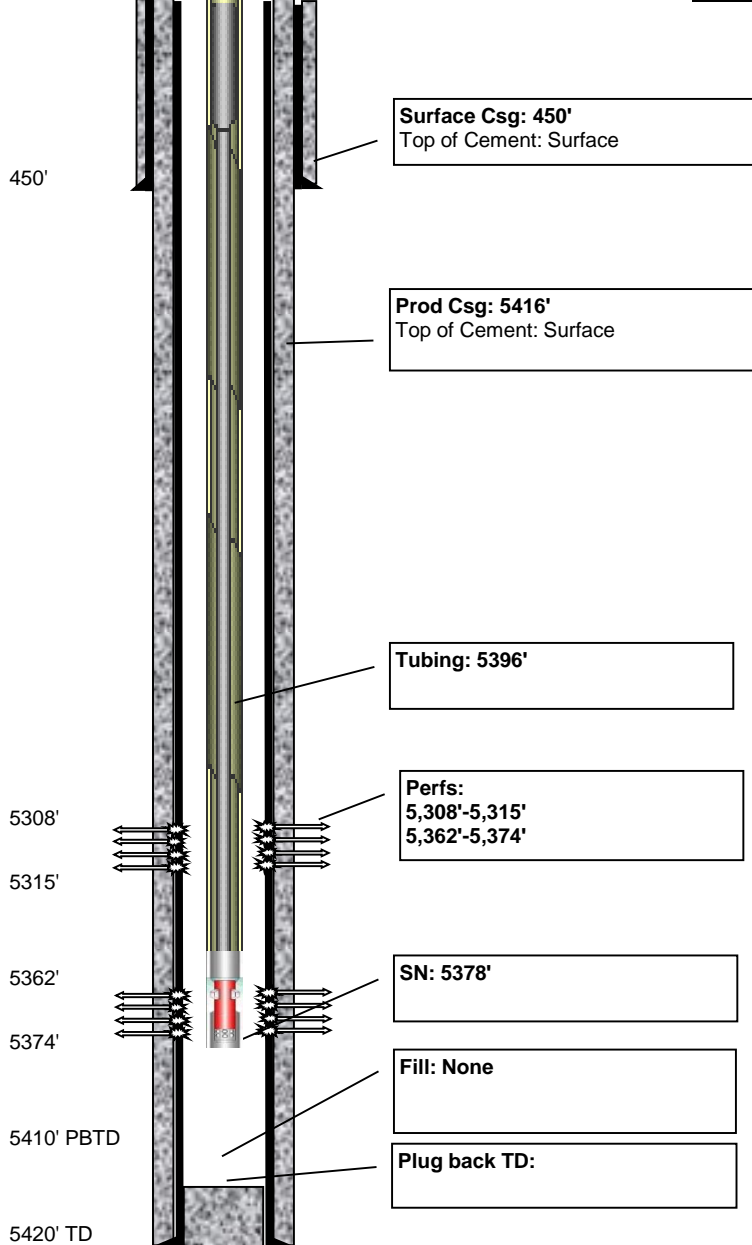

Perforations

Top	Bottom	SPF	Stimulation	OPEN?
5308	5315			
5362'	5374'		1800 gal 15% MCA	YES

Total = 12'

Casing

Depth	Size	Wgt (#)	Grade	Description
450'	8-5/8"			
5416'	5-1/2"			

Cement

Casing	Sacks	TOC	Description
8-5/8"	200	surface	200 sx 3% CC
5-1/2"	120	surface	120 sx Prem

Tubing

Description	Size	Length	Top	Bot
167 jts tbg	2-7/8"	5235'	0'	5235'
Tubing Subs		16'	5235'	5251'
TAC		3'	5251'	5254'
4 jts tbg		123'	5254'	5377'
SN		1'	5377'	5378'
MA+3' Perf Sub		18'	5378'	5396'

Rods

Description	Size	Length	Top	Bot
Polished Rod	1-1/2"	22'	-3'	19'
4 Pony Rods	7/8"	18'	19'	37'
150 Rods	7/8"	3750'	37'	3787'
63 Rods	3/4"	1575'	3787'	5362'
Pony Rod	7/8"	2'	5362'	5364'
Pump		18'	5364'	5382'

Pump

2-1/2" X 1-1/2" X 18' RWBC