




RECEIVED

JUN 20 1984

R. 55W

COLO. OIL & GAS CONS. COMM.

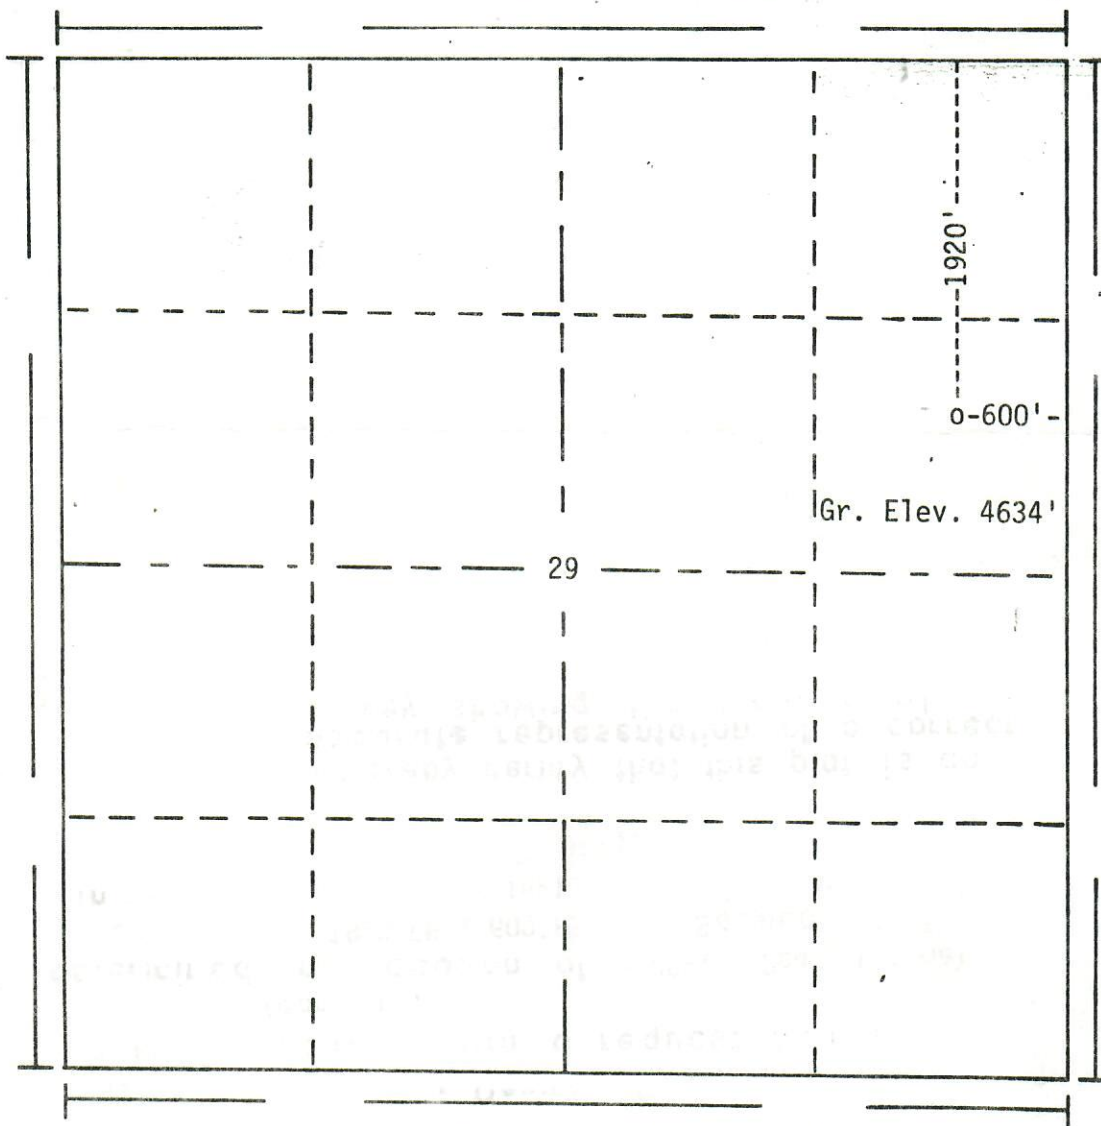

T. 12N


Scale... 1" = 1000'

Powers Elevation of Denver, Colorado
has in accordance with a request from Mr. Gear
for Oxoco Inc.
determined the location of No. 29-1 Peavy Channel
to be 1920' FN & 600' FE Section 29 Township 12N
Range 55W of the 6th Principal Meridian
Logan County, Colorado



00290933

I hereby certify that this plat is an
accurate representation of a correct
survey showing the location of

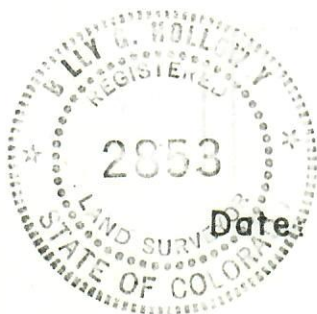

Date:

6-12-84

Billy G. Holloman
Licensed Land Surveyor No. 2853
State of Colorado