


COLORADO OIL AND GAS CONSERVATION COMMISSION
SUNDRY NOTICES AND REPORTS OF WELLS

RECEIVED
JUL 18 1956
OIL & GAS
CONSERVATION COMMISSION

(Indicate nature of data by checking below)



- Notice of intention to drill (attach plat) _____
- Notice of intention to change plans _____
- Notice of date for test of water shut-off _____
- Report on result of test of water shut-off _____
- Notice of intention to re-drill or repair well _____
- Notice of intention to clean out well _____
- Statement of shooting _____
- Statement of perforating _____
- Notice to pull or otherwise alter casing _____
- Notice of intention to abandon well XXXXXX
- Report of work done on well since previous report _____

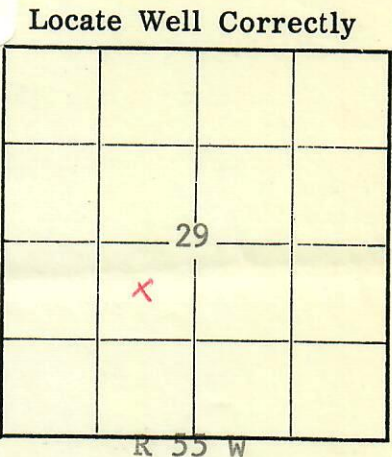

T
12
N

Notice to do work ☒ Land: Fee and Patented ☒
Report of work done ☐ State ☐ Lease No. _____

COLORADO LOGAN WILDCAT
State County Field

I NELSON NE 1/4 SW 1/4 29 12N R55W 6th P.
(Well No.) (Lease) (1/4 Sec.) (Sec.) (Twp.) (Range) (Meridian)

The Well is located 1980 Ft. (N) of Section Line and 1980 Ft. (E) of SW 1/4
Section Line. ~~(S)~~ ~~(W)~~

The elevation above sea level is 4626.7 Ft. GR. 4634 Ft. KB.

Details of Plan of Work: (State names of and expected depths to objective sands.
Show sizes, weights, and length of proposed casings; indicate mudding jobs, cementing
points, and all other important proposed work.)

Well was plugged and abandoned on July 16, 1956, after well was drilled
to a total depth of 995 Feet and both "D" and "J" Sands were tested,
as follows:

- Set first plug at 180 feet with 15 sacks cement
- Set second plug at 40 feet with 10 sacks cement

AJJ	
DVR	
FJK	
WRS	
HHM	
AH	
JJD	<input checked="" type="checkbox"/>
FILE	

Approved: JUL 19 1956
A. J. Garrison
Director

Date July 17, 1956
Company CHANDLER - MUSGROVE, INC.
210 Denver Club Building
Address Denver, Colorado
By Wayne R. Davy
Title Secretary-Treasurer

Submit reports of proposed work, for approval, on this form in Duplicate for patented
lands and in Triplicate for school and state lands.