




00923609

RECEIVED  
APR - 7 1966

OIL & GAS  
CONSERVATION COMMISSION

R. 55W

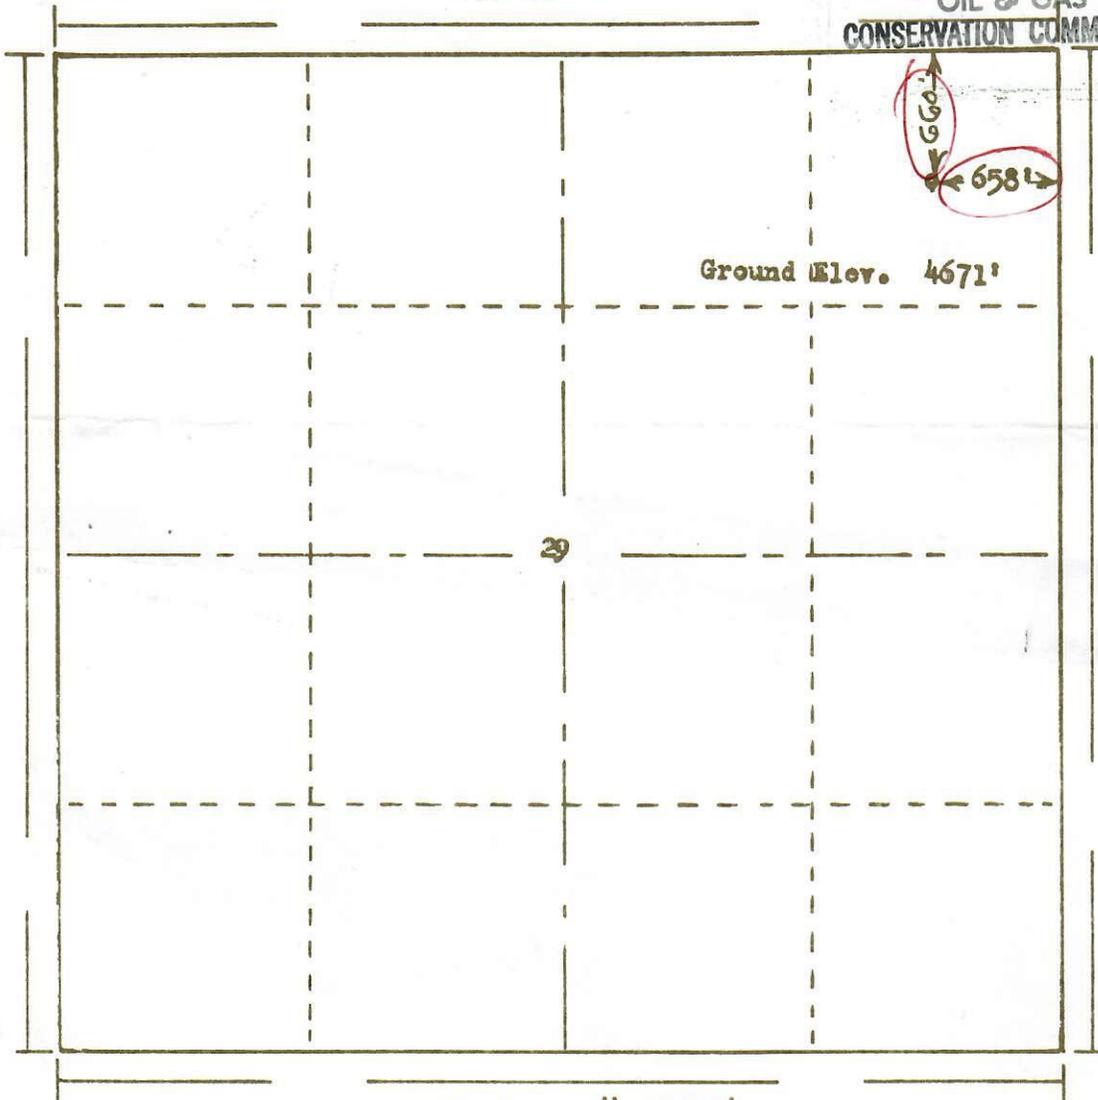

T.  
12  
E

Scale ... 1" = 1000'

Powers Surveyors, Inc. of Denver, Colorado  
 has in accordance with a request from Mr. Couch  
 for Bander & Couch determined the  
 Location of No. 5 Nelson  
 to be CNE NE Section 29 Township 12E  
 Range 55W of the 6th Principal Meridian  
 Logan County, Colorado

I hereby certify that this plat is an  
 accurate representation of a correct  
 survey showing the location of

Date: 4-1-66

*Bessie G. Hollaway*

Licensed Land Surveyor No. 2853  
State of Colorado

