OPERATOR:	K.P. Kauffman Company Inc.	**CNTY:**	WELD	**FTG:**	
WELL:	MARGUERITE TOTEMS B #2	**STATE:**	CO	**Q-Q:**	SWSW
FIELD:	SPINDLE	**SPUD:**	7/10/1976	**SEC.:**	20
API #	05-123-08795	**COMP:**	8/25/1976	**TWS:**	1N
LEASE #:		**STATUS:**	PR	**RGE:**	67W
UIC #:		**WBD DATE:**	8/17/2022	**BY:**	

CURRENT WELLBORE DIAGRAM

KBE: 5128 '
KB: 8 '
GLE: 5120 '

TD (ft): 5035 '
PBTD (ft): 4984 '

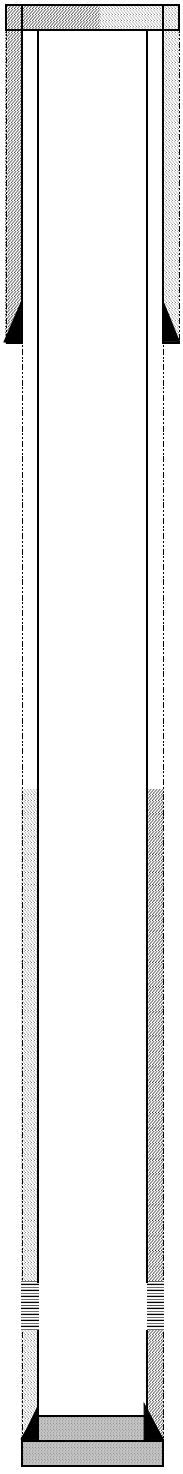

CASING RECORD

HOLE (in)	SIZE (in)	WT (lb/ft)	GRADE	TOP (ft)	BTM (ft)
12 1/4	8 5/8	24		0	906
7 7/8	4 1/2	10.5		0	5028

TUBING RECORD

SIZE (in)	WT (lb/ft)	GRADE	JOINTS	BTM (ft)

PERFORATION RECORD

ZONE	TOP (ft)	BTM (ft)	HOLES	STAGE	STATUS
SUSSEX	4885	4914	60		