




# P&A Wellbore For State

Well Name: KILDOW C31- 7X

Land, Original Hole, 11/2/2022 5:42:52 PM

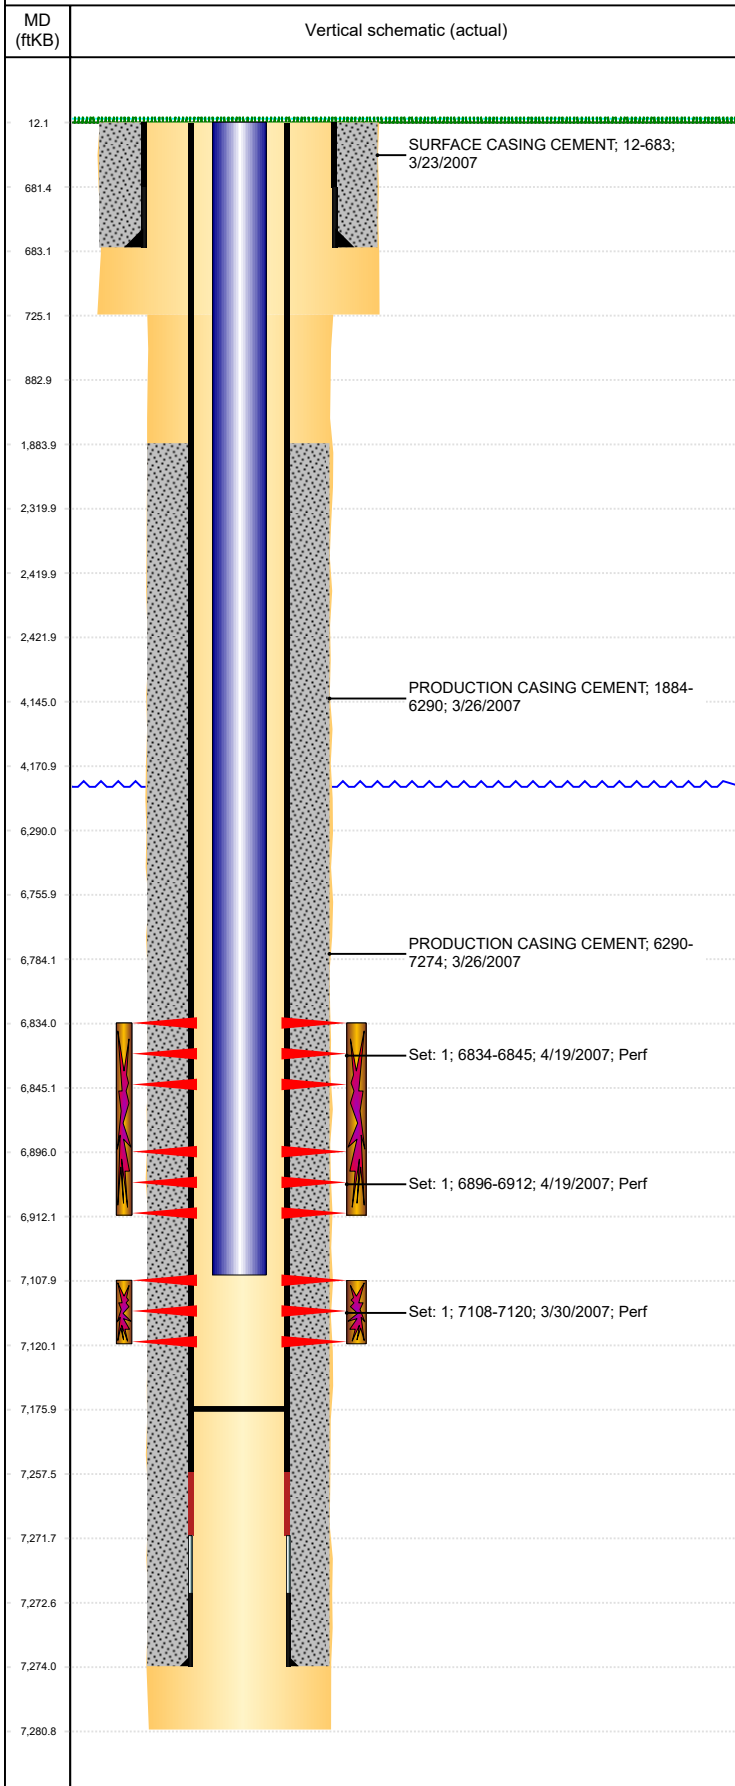

## Well Header

Surface UWI 0512324405		Business Unit Rockies		Gov Auth Dist		Prod Tree Loc Land			
Orig. KB to Gnd (ft) 12.00		Original Spud Date 3/22/2007		Abandon Date		Well Sub-Status SI		High... N	
Comment									

## Surface Location (Congressional)

Qtr 3 SW	Qtr 4 NE	Section 31	Twtnshp 4	Twtnsh... N	Range 64	Rng E/... W	Latitude (°) 40.27022429 4	Longitude (°) -104.590768047
-------------	-------------	---------------	--------------	----------------	-------------	----------------	----------------------------------	---------------------------------

## Wellbore Sections

Section Des	Hole Size (in)	Act Top (ftKB)	Act Btm (ftKB)
SURFACE	12 1/4	12.0	725.0
PRODUCTION	7 7/8	725.0	7,281.0

## Casing Strings

Csg Des	Run Date	OD (in)	Wt/Len (lb/ft)	Grade	Top Depth (MD) (ftKB)	Set Depth (MD) (ftKB)
Surface	3/23/2007	8 5/8	24.00		12	683
Production Casing	3/25/2007	4 1/2	11.60	M-80	12	7274

## Cement

Des	Start Date	Top (ftKB)	Btm (ftKB)
SURFACE CASING CEMENT	3/23/2007	12.0	683.0
PRODUCTION CASING CEMENT	3/26/2007	1,884.0	6,290.0
PRODUCTION CASING CEMENT	3/26/2007	6,290.0	7,274.0

## Zone Statuses

Zone Name	Status Date	Status	Fluid Type	Job	Prod Method
CODELL	4/21/2007	PR		DRILLING/COMPLETION - ORIGINAL, 3/22/2007...	
CODELL	3/22/2017	SI			
NIOBRARA	4/21/2007	PR		DRILLING/COMPLETION - ORIGINAL, 3/22/2007...	
NIOBRARA	3/22/2017	SI			

## Perforation Data

Linked Zone	Explosive Type	Entered Shot Total	Top (ftKB)	Btm (ftKB)	Date
NIOBRARA, Original Hole		44	6,834.0	6,845.0	4/19/2007
NIOBRARA, Original Hole		64	6,896.0	6,912.0	4/19/2007
CODELL, Original Hole		48	7,108.0	7,120.0	3/30/2007

## Stimulation Intervals

Zone	Start Date	Top (ftKB)	Btm (ftKB)
NIOBRARA, Original Hole	4/19/2007	6,834.0	6,912.0
NIOBRARA, Original Hole	4/19/2007	6,834.0	6,912.0
CODELL, Original Hole	4/19/2007	7,108.0	7,120.0

## Other In Hole

Run Date	Des	Make	OD (in)	Top (ftKB)	Btm (ftKB)

## Logs

Date	Type	Depth Top (MD) (ftKB)	Btm (ftKB)
3/25/2007	CBL/CCL/GR	1,728	7,225.0
3/25/2007	COMPENSATED DENSITY	2,790	7,263.0
3/25/2007	INDUCTION	683	7,283.0

## Plug Back Total Depths

Date	Type	Com	PBTD (ftKB)
3/25/2007	FLOAT COLLAR	TOP OF FLOAT COLLAR	7,258
8/22/2007	FILL	CLEAN OUT PRIOR TO LAND TUBING	7,176