



RECEIVED
SEP 07 1983

Date: August 30, 1983

Operator: GETTY OIL COMPANY
COLO. OIL & GAS CONS. COMM.

Well: T. W. CHAMIS No. 1

System: OPEN

Location: Sec. 34 Twp. 4 Rng. 59


Gas Purchaser: DANCON OIL CO.

County: MORGAN State: COLO

Gas Sales Meter No: A 30501

Lease No: 01355-A

CANON FIELD COMMUNITIZATION AGREEMENT # 007946

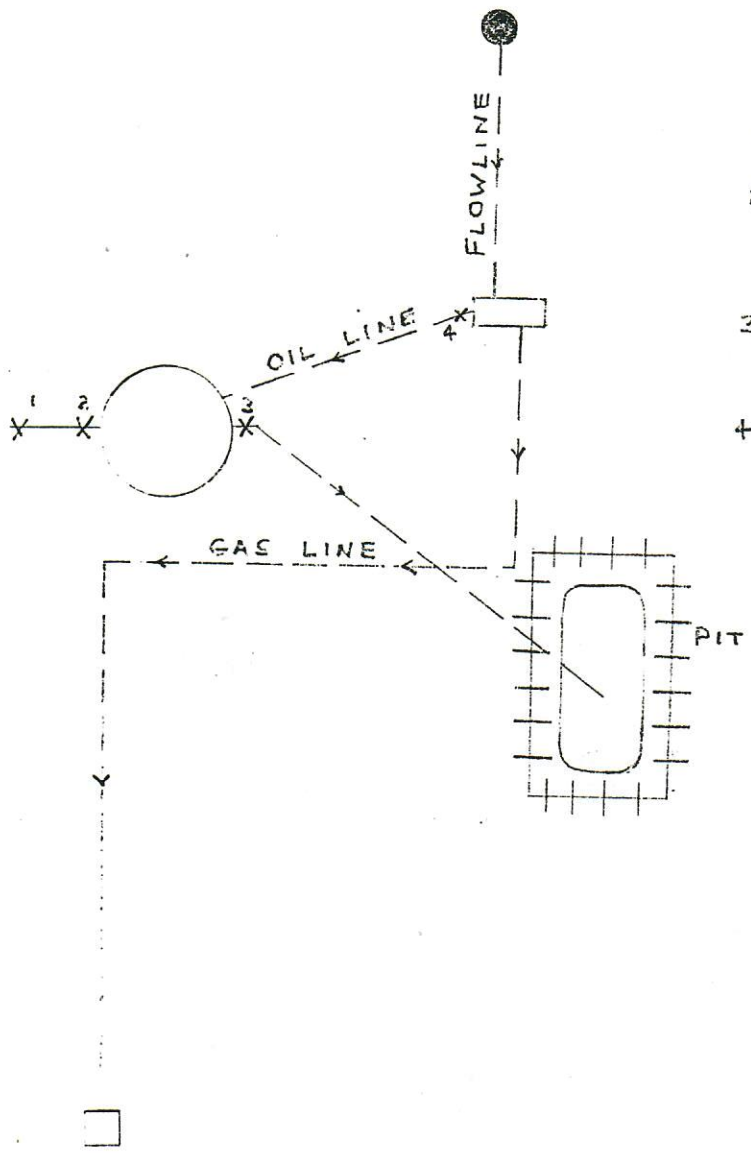

VALVES

- 1 - 2" SEALED PLUG VALVE (CLOSED)
- 2 - 3" SEALED PLUG VALVE (CLOSED)
(PADLOCKED)
- 3 - NON-FREEZE VALVE (CLOSED
AND SEALED)
- 4 - AUTOMATIC DUMP VALVE

11. 24