




R. 59W

RECEIVED

OCT 6 - 1967

COLO. OIL & GAS CONS. COMM.

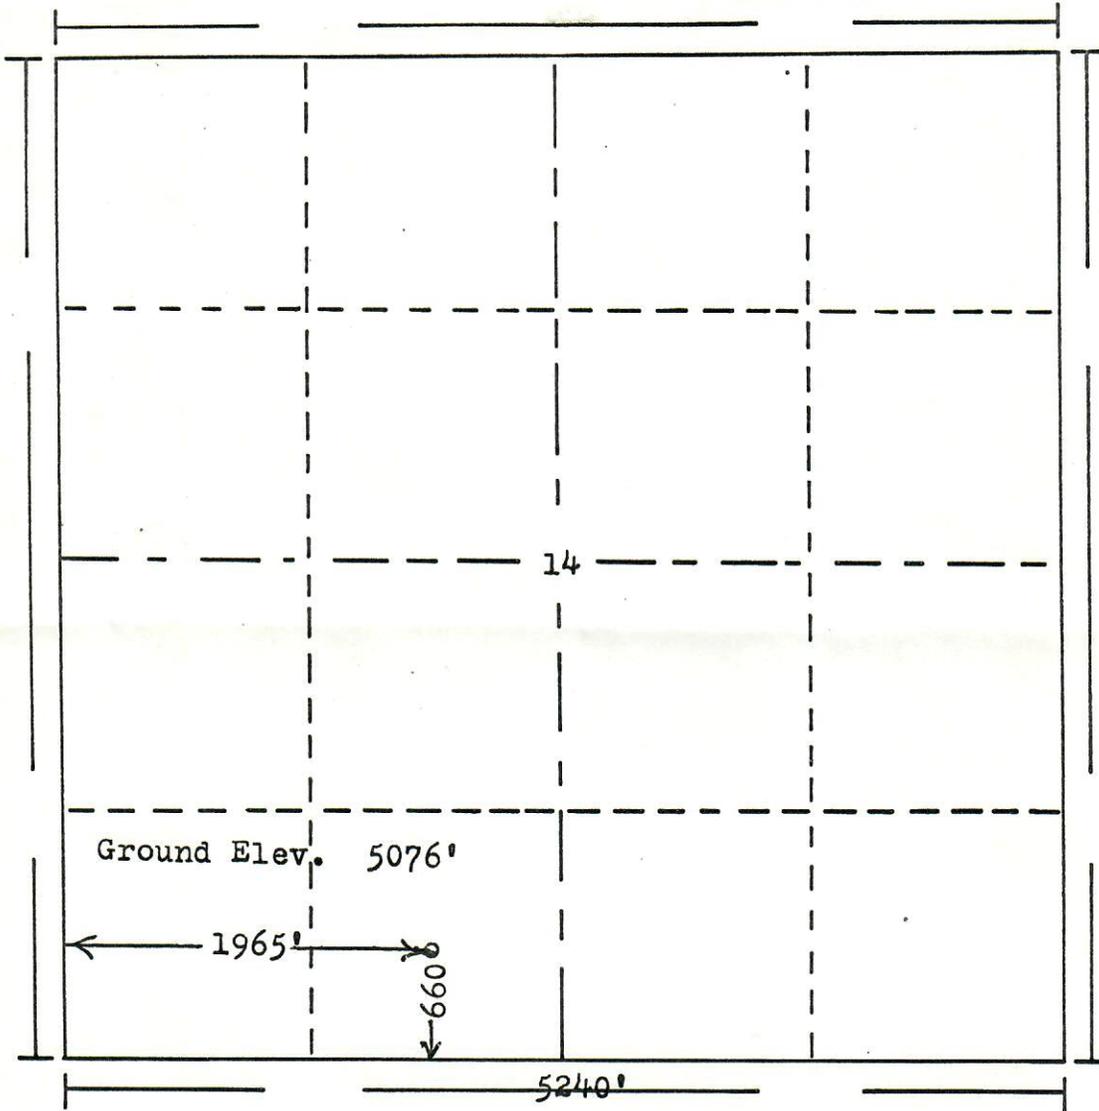

T.
3
S

Scale... 1" = 1000'

Powers Elevation Company, Inc. of Denver, Colorado has in accordance with a request from Mr. Wakefield for Anschutz Corp.

determined the location of No. 1 Townsend to be CSE SW Section 14 Township 3S Range 59W of the 6th Principal Meridian Adams County, Colorado

I hereby certify that this plat is an accurate representation of a correct survey showing the location of



Date: 10-2-67

B. G. Holloway
Licensed Land Surveyor No. 2853
State of Colorado