




00230261

RECEIVED

OCT 7 1971

R. 59W

COLO. OIL & GAS CONS. COMM.

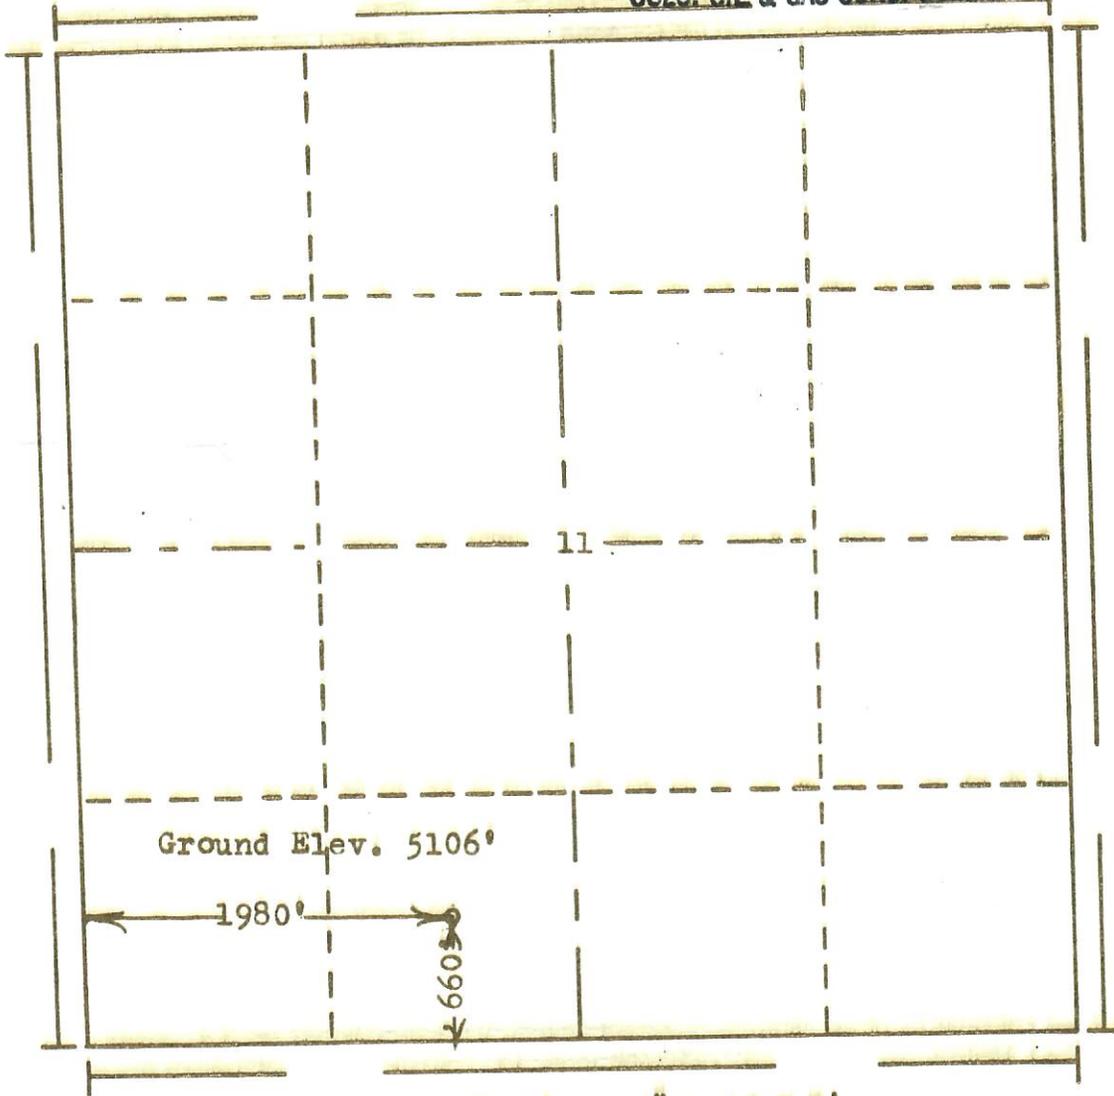

T. 35

Scale... 1" = 1000'

Powers Elevation Company, Inc. of Denver, Colorado has in accordance with a request from Mr. Durr for Edward Mike Davis

determined the location of No.1 UPRR-Flader to be CSE SW Section 11 Township 35 Range 59W of the 6th Principal Meridian Adams County, Colorado

I hereby certify that this plat is an accurate representation of a correct survey showing the location of

Date: 9-29-71

B. J. Hallman
Licensed Land Surveyor No. 2853
State of Colorado

71-755