| | | | | | |
|---|---|---|---|---|---|
| **OPERATOR:** | K.P. Kauffman Company Inc. | **CNTY:** | DACONO/WELD | **FTG:** | |
| **WELL:** | PELTIER #2 | **STATE:** | CO | **Q-Q:** | NWNE |
| **FIELD:** | SPINDLE | **SPUD:** | 12/18/1976 | **SEC.:** | 1 |
| **API #** | 05-123-09060 | **COMP:** | 3/27/1977 | **TWS:** | 1N |
| **LEASE #:** | | **STATUS:** | SI | **RGE:** | 68W |
| **UIC #:** | | **WBD DATE:** | 9/9/2022 | **BY:** | |

## CURRENT WELLBORE DIAGRAM

**KBE:** 5021 '
**KB:** 10 '
**GLE:** 5011 '

**TD (ft):** 5260 '
**PBTD (ft):** 5210 '

**CASING RECORD**

| HOLE (in) | SIZE (in) | WT (lb/ft) | GRADE | TOP (ft) | BTM (ft) |
|---|---|---|---|---|---|
| 12 1/4 | 8 5/8 | 24 | | 0 | 786 |
| 7 7/8 | 4 1/2 | 10.5 | | 0 | 5244 |

**TUBING RECORD**

| SIZE (in) | WT (lb/ft) | GRADE | JOINTS | BTM (ft) |
|---|---|---|---|---|
| | | | | |

**PERFORATION RECORD**
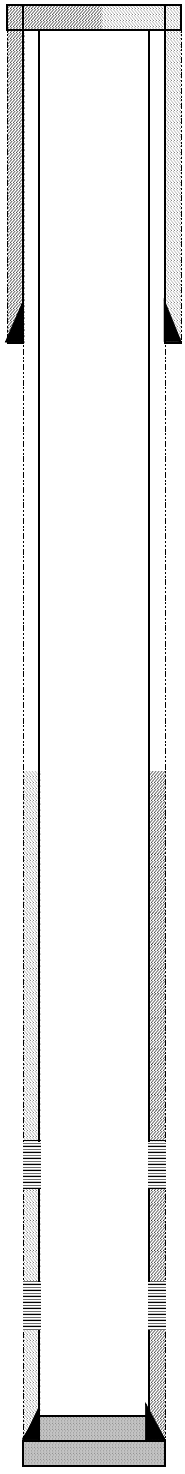
| ZONE | TOP (ft) | BTM (ft) | HOLES | STAGE | STATUS |
|---|---|---|---|---|---|
| SUSSEX | 4682 | 4712 | 62 | | |
| SHANNON | 5102 | 5142 | 82 | | |