

Colo. St.


RECEIVED

JUN 25 1968

COLO. OIL & GAS CONS. COMM.



R. 58W

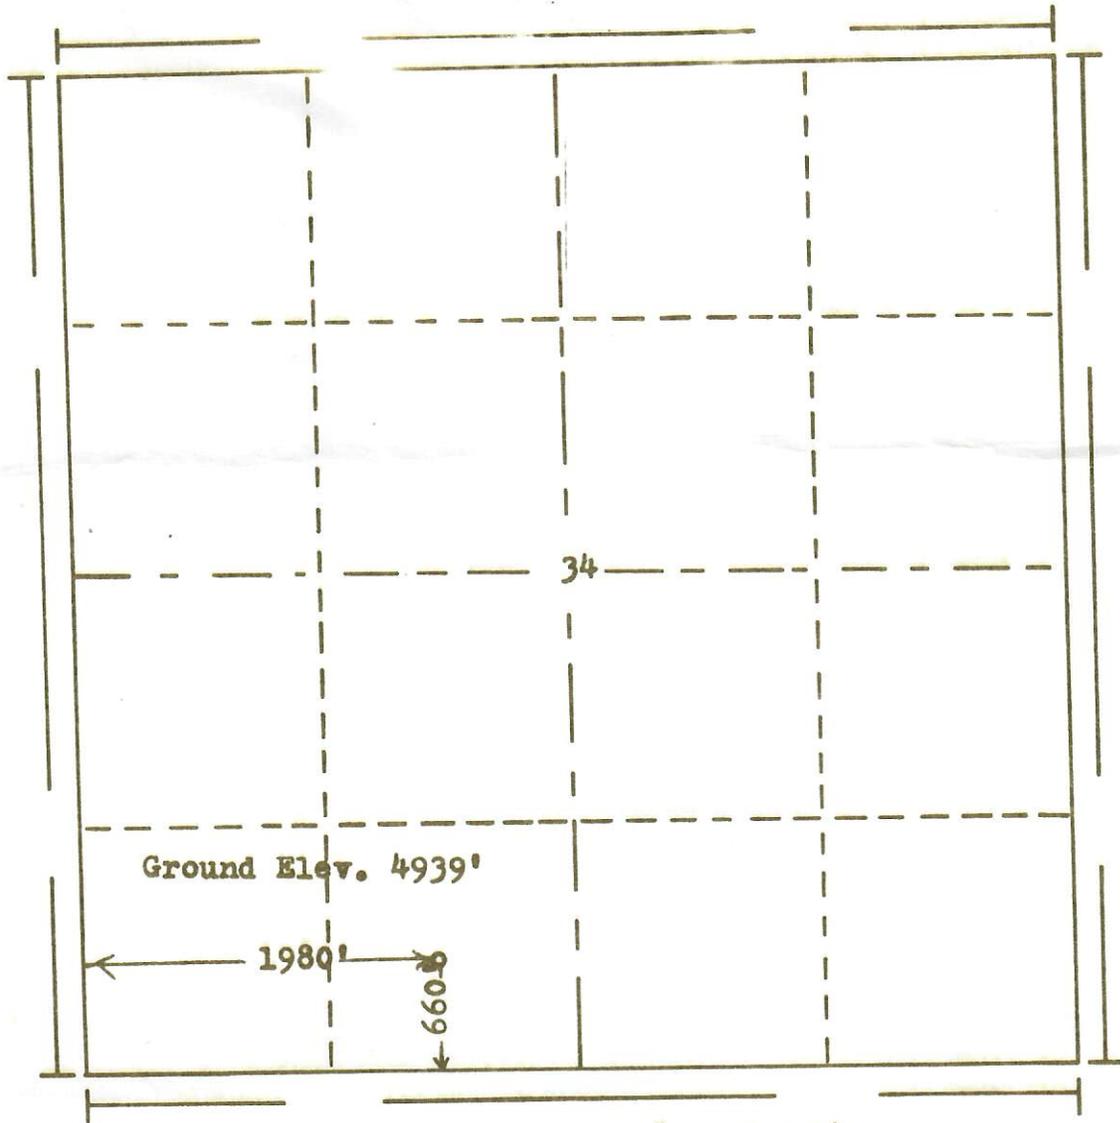

T. 3 S

Scale... 1" = 1000'

Powers Elevation Company, Inc. of Denver, Colorado has in accordance with a request from Mr. Gasch for Toltek Drlg. Co.

determined the location of No. 1-A # Jolly to be CSE SW Section 34 Township 3S Range 58W of the 6th Principal Meridian Adams County, Colorado

I hereby certify that this plat is an accurate representation of a correct survey showing the location of

68-218

68-218

Date 6-19-68

Bess G. Hollman
Licensed Land Surveyor No. 2853
State of Colorado