OPERATOR: K.P. Kauffman Company Inc.
WELL: UPRR 42 PAN AM AH #1
FIELD: SPINDLE
API # 05-123-09085
LEASE #:
UIC #:

CNTY: DACONO/WELD
STATE: CO
SPUD: 1/4/1977
COMP: 5/2/1977
STATUS: SI
WBD DATE: 9/19/2022

FTG:
Q-Q: NWSE
SEC.: 1
TWS: 1N
RGE: 68W
BY:

CURRENT WELLBORE DIAGRAM

KBE: 5040 '
KB: 10 '
GLE: 5030 '

TD (ft): 5267 '
PBTD (ft): 5206 '

12.25" Hole
8.625" 24# Csg @ 750 '
Cmtd w/800 sxs

TOC @ 3239 '
Calc Assuming 1.15 yield

7.875" Hole
4.5" 10.5# Csg @ 5258 '
Cmtd w/400 sxs

SUSSEX Perfs
4708'-4738'

SHANNON Perfs
5136'-5150'

PBTD (ft): 5206 '
TD (ft): 5267 '

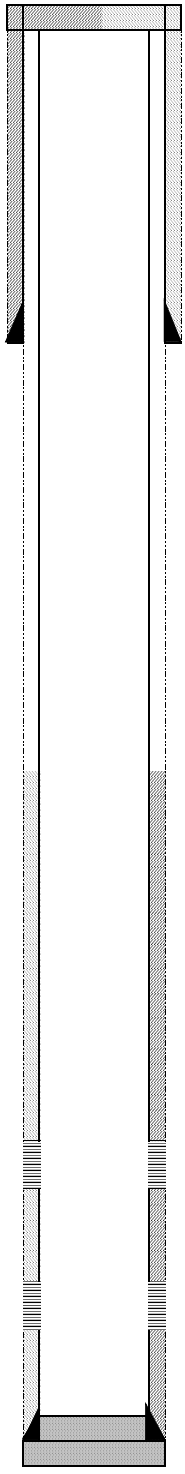

CASING RECORD

HOLE (in)	SIZE (in)	WT (lb/ft)	GRADE	TOP (ft)	BTM (ft)
12 1/4	8 5/8	24		0	750
7 7/8	4 1/2	10.5		0	5258

TUBING RECORD

SIZE (in)	WT (lb/ft)	GRADE	JOINTS	BTM (ft)

PERFORATION RECORD

ZONE	TOP (ft)	BTM (ft)	HOLES	STAGE	STATUS
SUSSEX	4708	4738	62		
SHANNON	5136	5150	30		