





<b>Date:</b> Nov / 08 / 2022	<b>Operator:</b> Jeremy Georgeson	<b>API:</b> 05-123-30510	
<b>Well:</b> 43-19	<b>Field:</b> Civitas	<b>Location:</b> Antelope	
<b>S/N:</b> 1820	<b>Last Calibration:</b> 6/3/2022 9	<b>SW Ver:</b> 1.485	
<b>Incline:</b> Vertical	<b>Grid Offset:</b> 0.00	<b>Depth Input:</b> Manual	
<b>Units:</b> Imp. US	<b>Latitude:</b> 40.38306 N	<b>Start Depth:</b> 100 usft	<b>Bottom Depth:</b> 6200 usft
<b>Coords:</b> Geographical	<b>Altitude:</b> 0.00 usft	<b>N/S:</b> 0.00 usft	<b>E/W:</b> 0.00 usft


**TVD vs Distance**

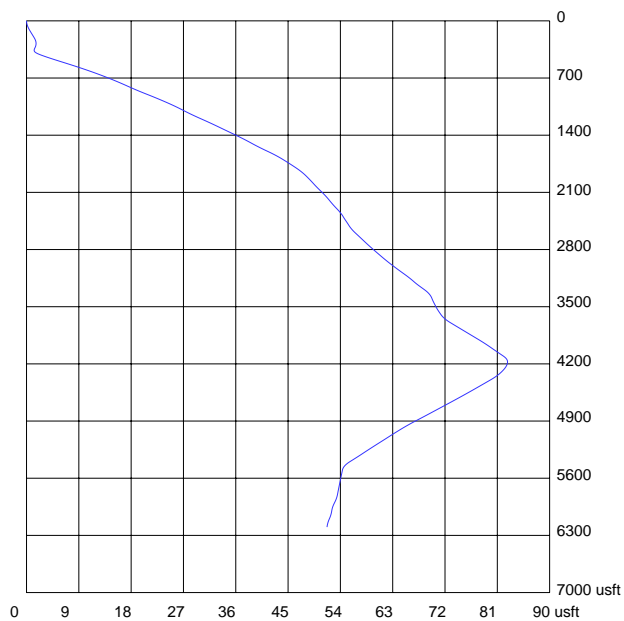

**Top View**

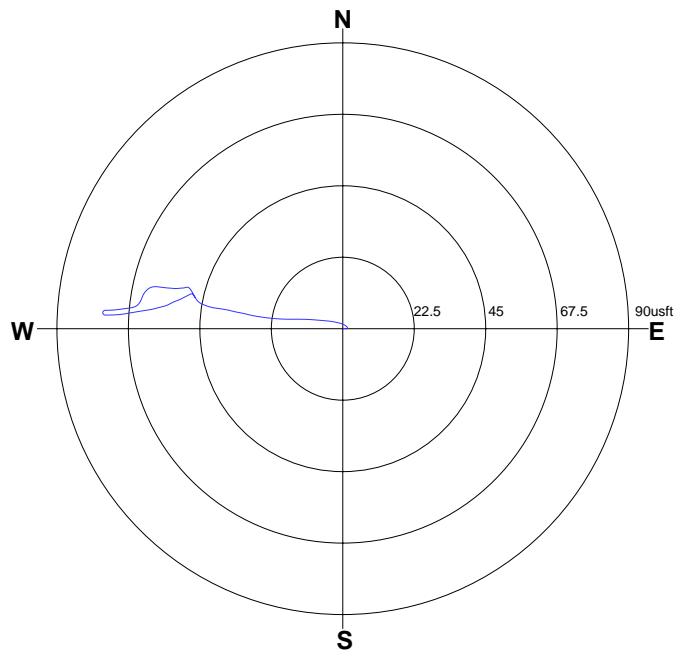

**3D View**

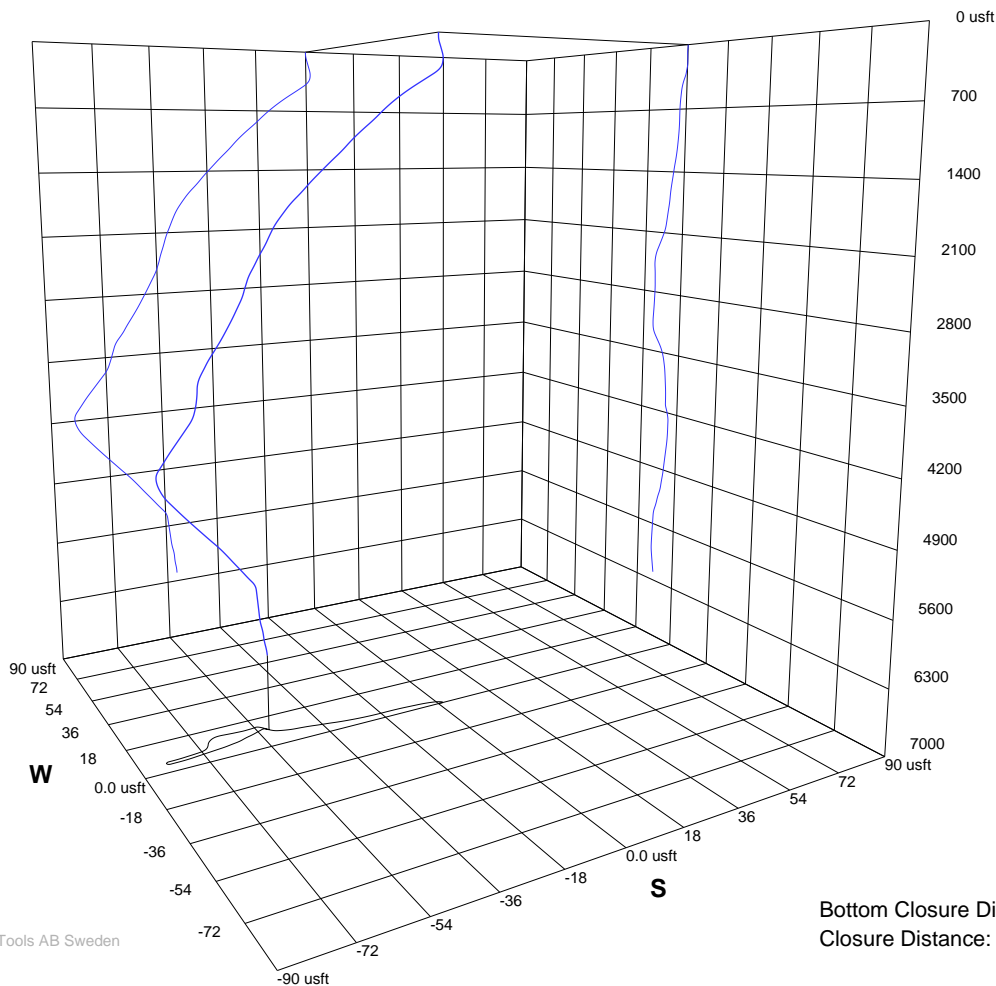

Bottom Closure Direction: 278.42 degrees  
Closure Distance: 53.25 usft