

F. S. Duncan B - 12
532' FSL, 168' FEL, SEC 20 T12N R100W
Moffat County, CO


GL @ 6918'
 KB @ 6934'
 COMPLETION DATE: 12/02/2002

API #05-081-07075

SURFACE CASING
 8-5/8" 24# K-55
 SET @ 858'
 CMT w/ 455 sx

PROD. CASING
 4 1/2", 11.6#, P-110
 SET @ 5300'
 CMT w/ 1110 sx

	<u>LENGTH</u>	<u>TOP DEPTH</u>
	(FT)	(FT)
PRODUCTION TBG		
KB	16.0	-16.0
Tbg Hanger	0.8	16.0
2-3/8", 4.7#, L-80, API 8-rd tbg	4518.2	16.8
XN' nipple	1.1	4535.0
2-3/8", 4.7#, L-80, API 8-rd tbg	31.5	4536.1
WLEG	0.41	4567.6
EOT		4568.01

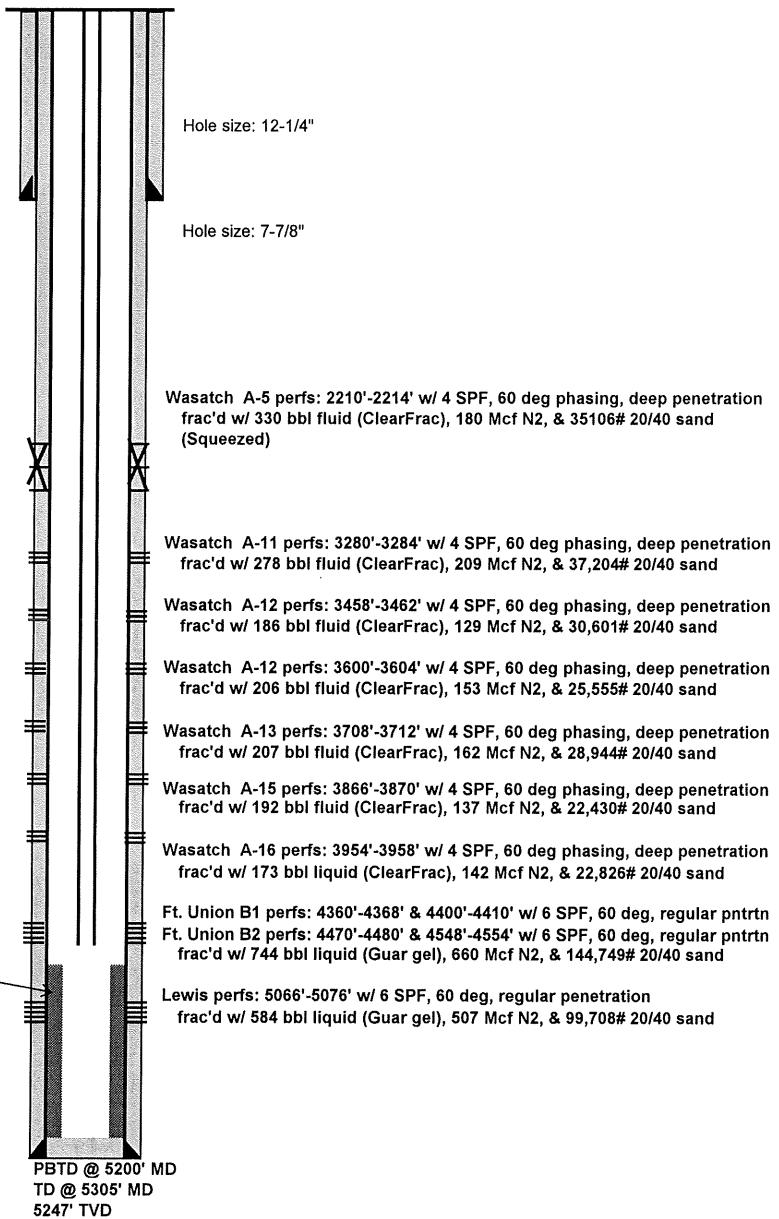

CO with undergauge bit to 5,186', scraper held up at 4,688', CO w/ 3.85" watermelon mill to 4,745'

Updated Oct 2011, TBWI