



R. 59W

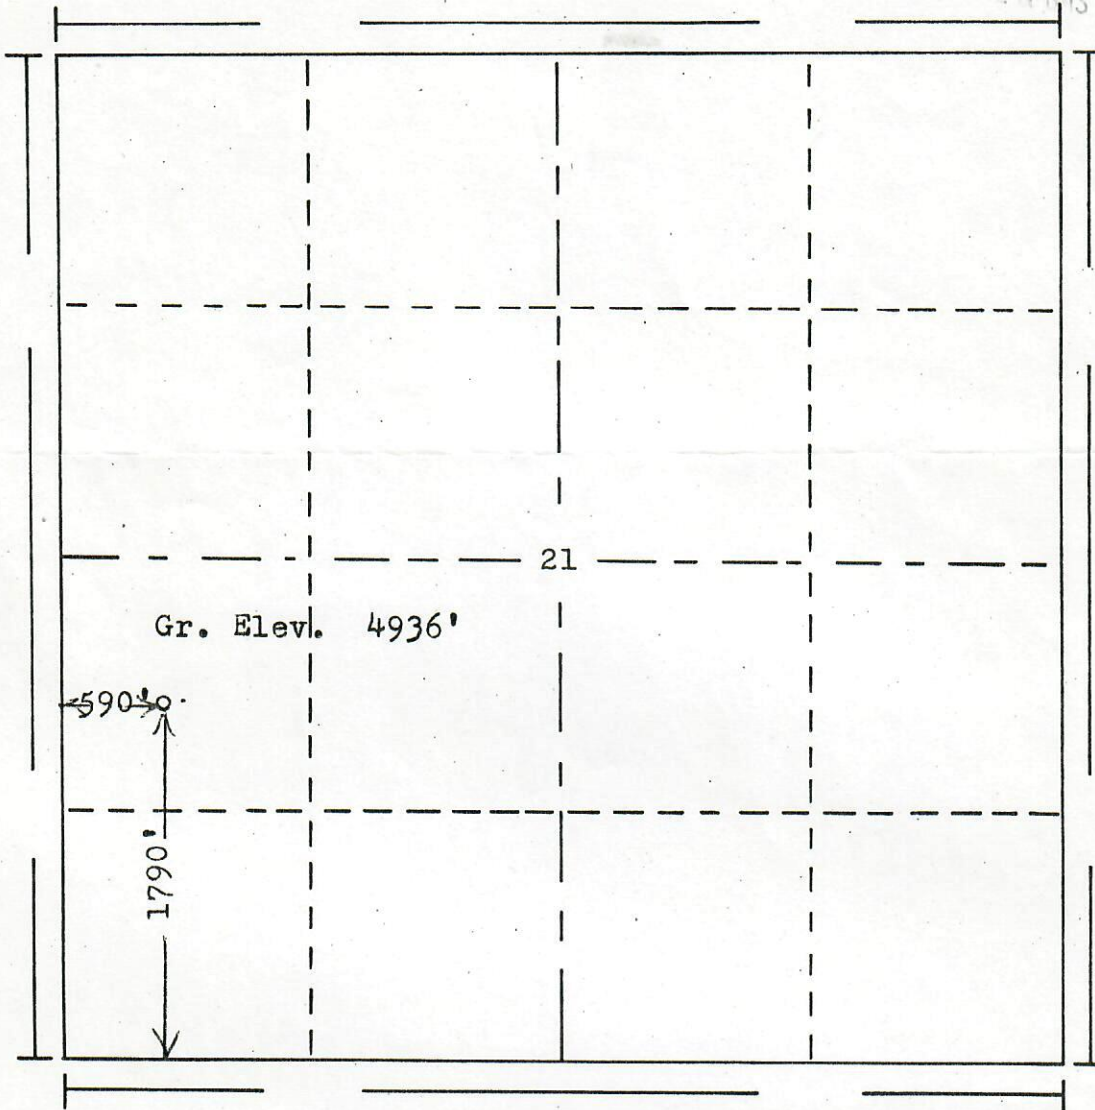
MAR 16 1976

RECEIVED

MAR 29 1976

COLO. OIL &amp; GAS CONS. COM.

N

T.  
3  
S

Scale... 1" = 1000'

76-185

**Powers Elevation Company, Inc. of Denver, Colorado**  
has in accordance with a request from Mr. Huckabay  
for E. Doyle Huckabay, Ltd.  
determined the location of No. 1-21 Amoco-Price  
to be 1790' FS & 590' FW Section 21 Township 3S  
Range 59W of the 6th Principal Meridian  
Adams County, Colorado

I hereby certify that this plat is an  
accurate representation of a correct  
survey showing the location of

Date: 3-11-76

*B. J. Hall*  
Licensed Land Surveyor No. 2853  
State of Colorado